


T.17S.,R.3W.,W.M.

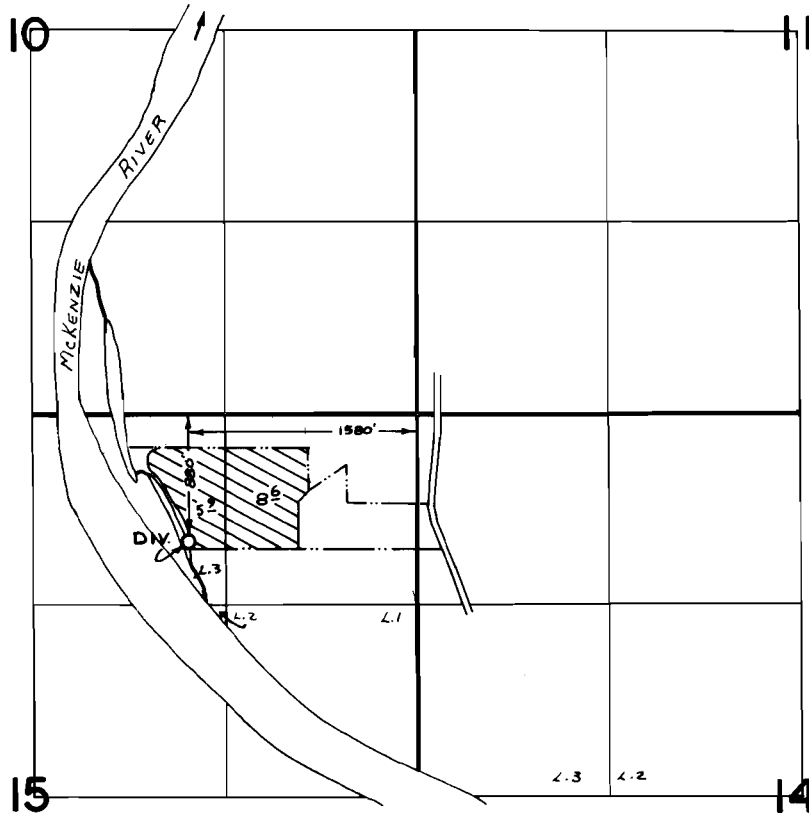

**FINAL PROOF SURVEY**  
UNDER

Application No. 58903.. Permit No. 44872.....  
IN NAME OF

**ROY E. & MARY L. ADKINS**

Surveyed Sept. 14. 1981., by S.C. BROWN.....