


T. 2 S. R. 3 W. W.M.

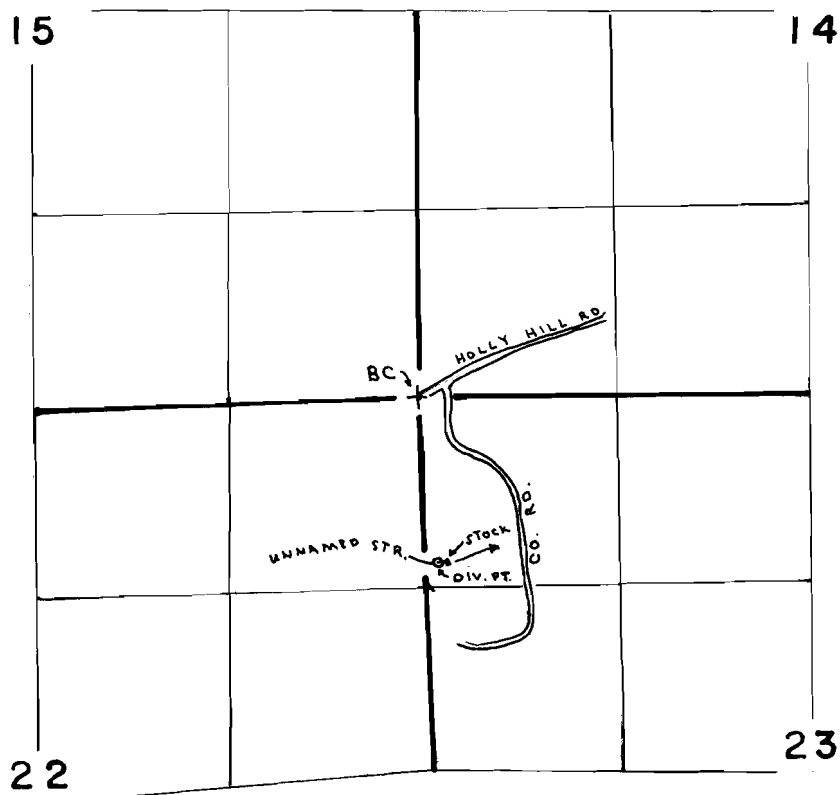

DIV. PT. LOC. 1130' S. & 100' E. OF NW COR. SEC. 23

FINAL PROOF SURVEY
UNDER

Application No. 60038 Permit No. 45027
IN NAME OF

JACK L. VANDERVEST

Surveyed JUL 26 1984, by P. PAGTER