


T. 36 S., R. 4 W., W. M.

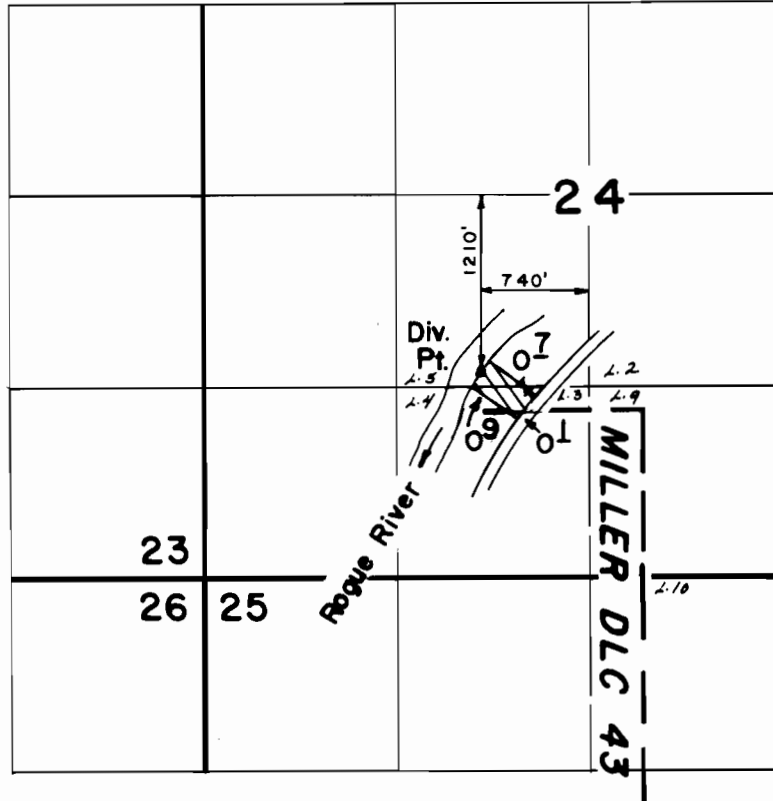

Scale: 1" = 1320'

**FINAL PROOF SURVEY**  
UNDER

Application No. 60568 Permit No. 45311

IN NAME OF

DELBERT &/OR PIXIE CASEY

Surveyed JUL 2 1986, by B. S. JAMES