


# T.25 S., R.7 W., W.M.

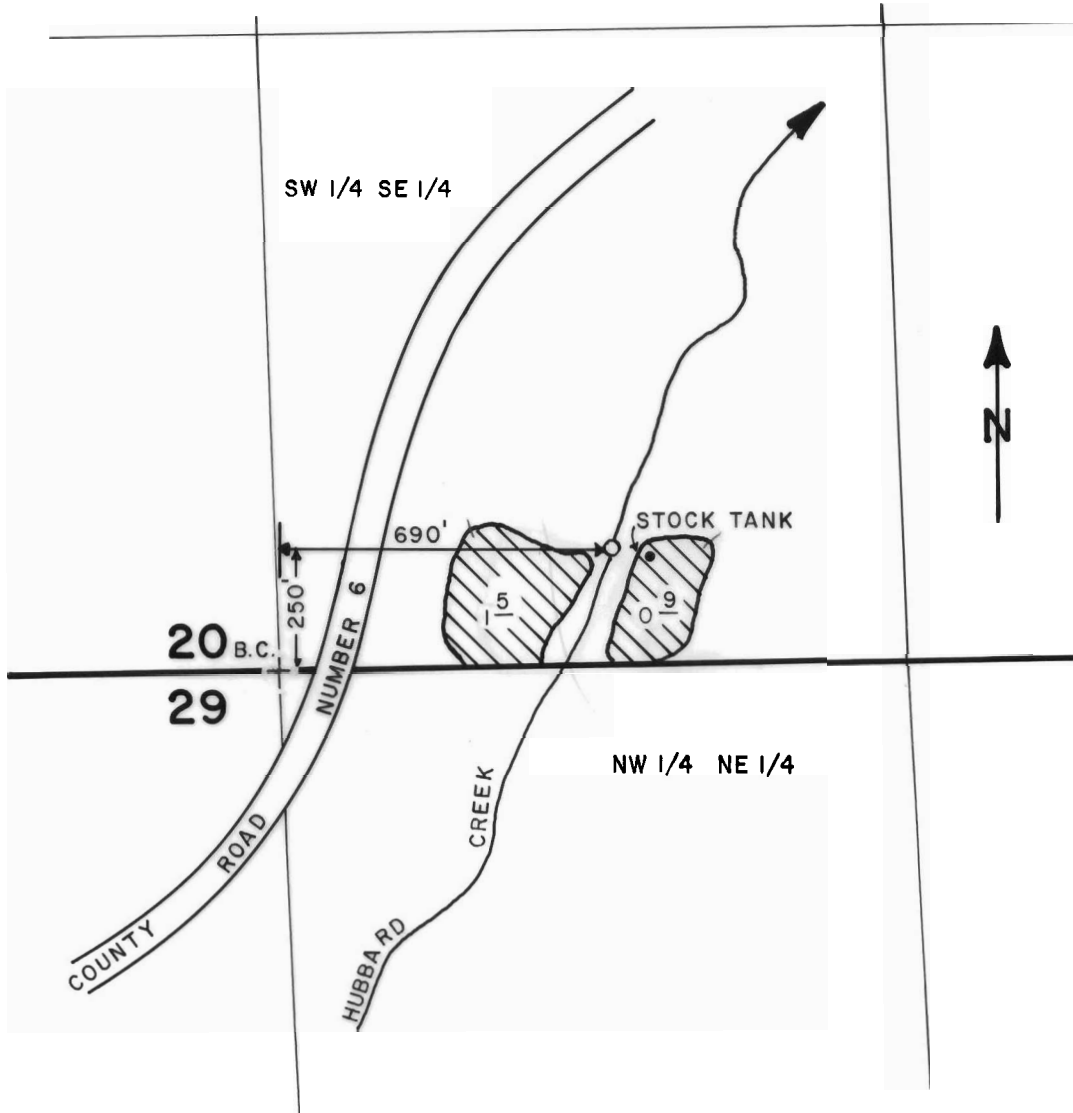

SCALE: 1" = 400'

## FINAL PROOF SURVEY UNDER

Application No. 60039 Permit No. 45390  
IN NAME OF

.....WILLIS M. MILLER.....

Surveyed AUG. 5, 1986, by JOHN M. SCHMORDE