


T.6S., R.6 & 7W., W.M.

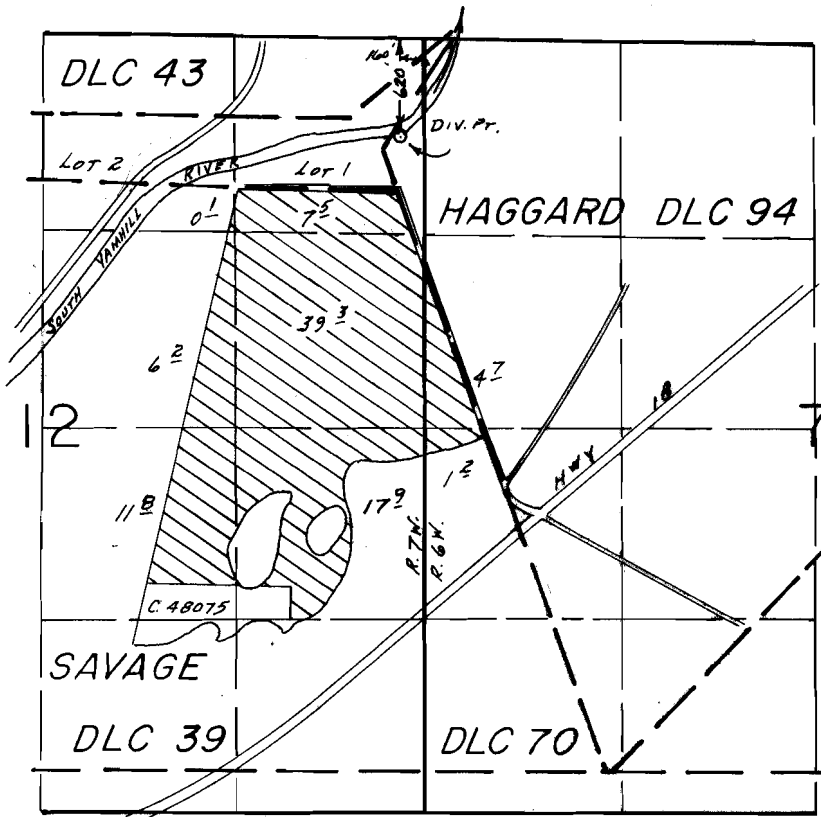

SCALE : 1" = 1320'

FINAL PROOF SURVEY
UNDER

Application No. 61266 Permit No. 45581.....
IN NAME OF

RICHARD M. KIRKHAM.....

Surveyed June 29 1987, by B.W. BISHOP.....