




T.23S.,R.13W.,W.M.

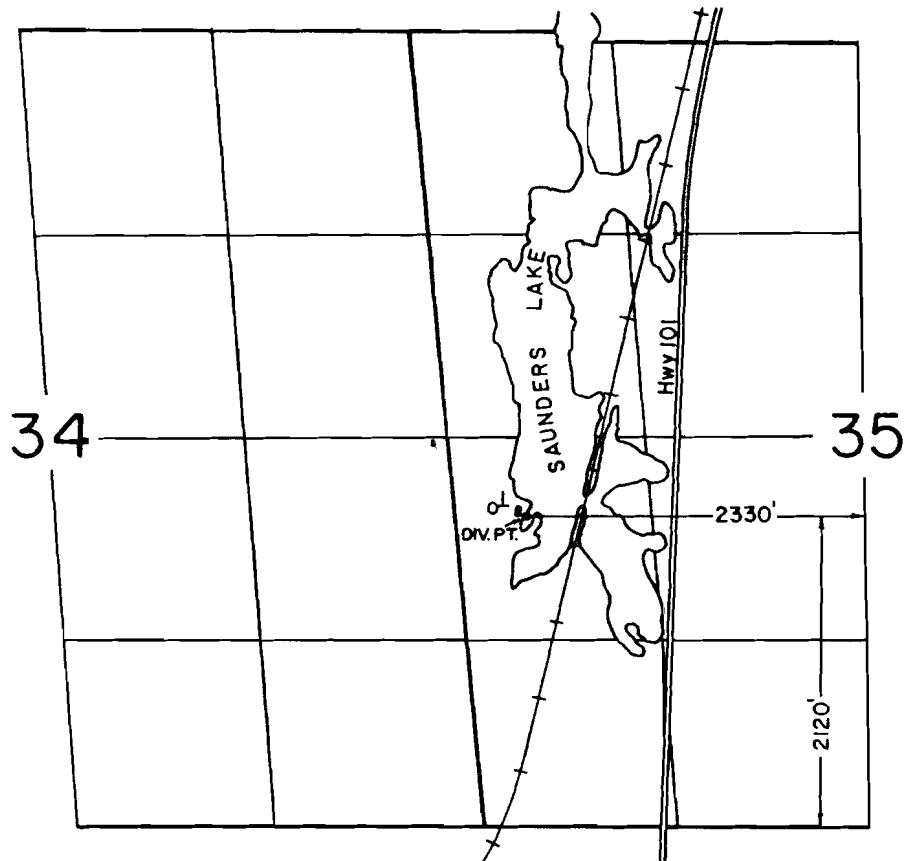

SCALE: 1" = 1320'

**FINAL PROOF SURVEY**  
UNDER

Application No. 62346. Permit No. 46494.....  
IN NAME OF

.....RICHARD C. BROWN.....

Surveyed SEPT. 17, 1988, by V. L. CHURCH.....