



T. 41 S., R. 13 W., W.M.

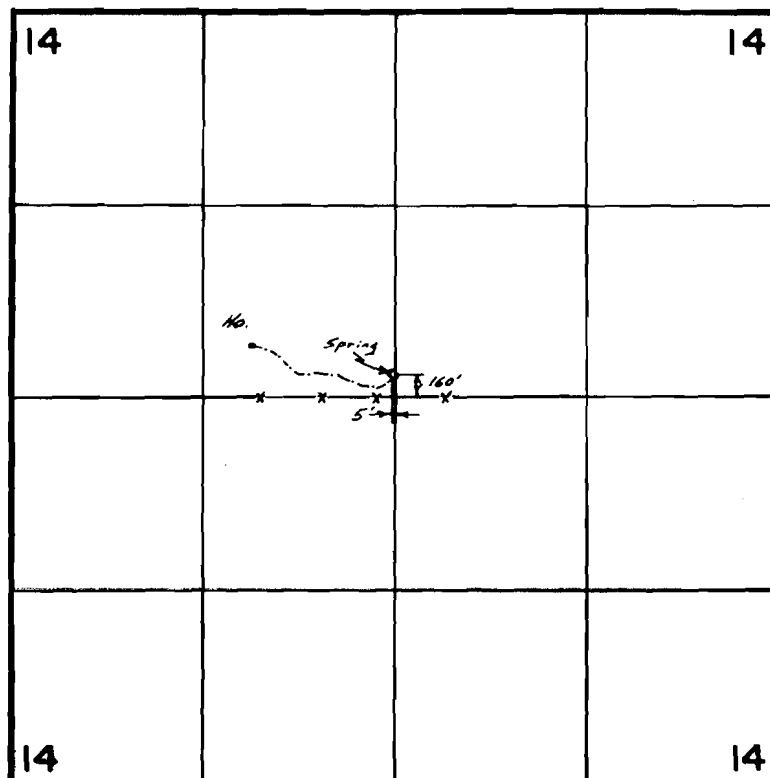

Scale 1"=1320'

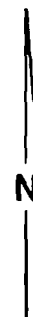

FINAL PROOF SURVEY
UNDER

Application No. 63208. Permit No. 46917.....
IN NAME OF

.....**RANDALL J. GERLACH**.....

Surveyed April 12, 1985, by L. E. CASHION..