


T. 37S., R. 6 W., W.M.

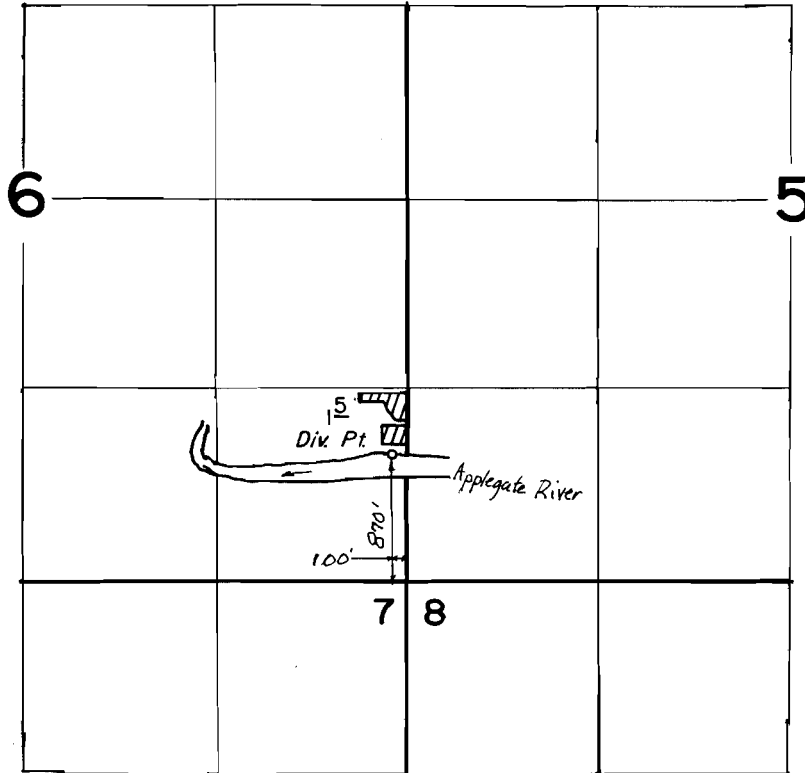

FINAL PROOF SURVEY
UNDER

Application No. 62250.. Permit No. 46944.....
IN NAME OF

TOM & PAULA PATTEE

Surveyed OCT. 18, 1983., by B. S. JAMES.....