


T. 4S., R. 3W., W.M.

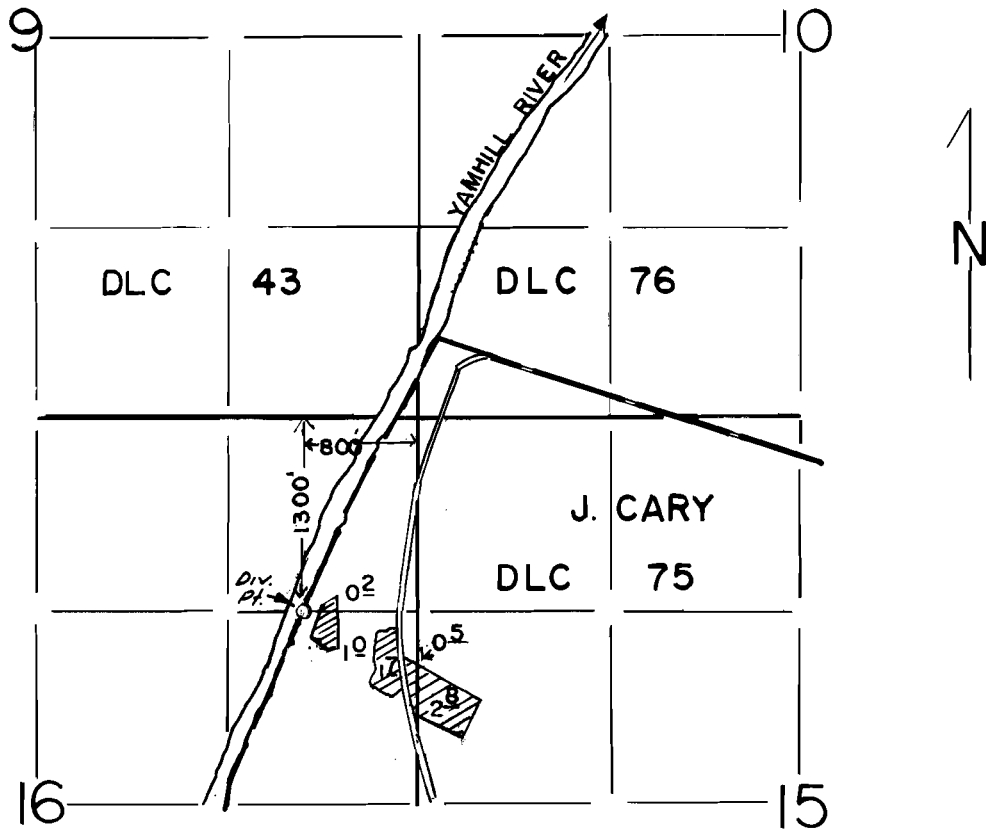

SCALE: 1"=1320'

**FINAL PROOF SURVEY**  
UNDER

Application No. ...63823 Permit No. ...47003.....  
IN NAME OF

.....FOREST...L...MILLER.....

Surveyed OCT...5... 19.87, by .B.W..BISHOP.....