


T. 4 S., R. 4 W., W. M.

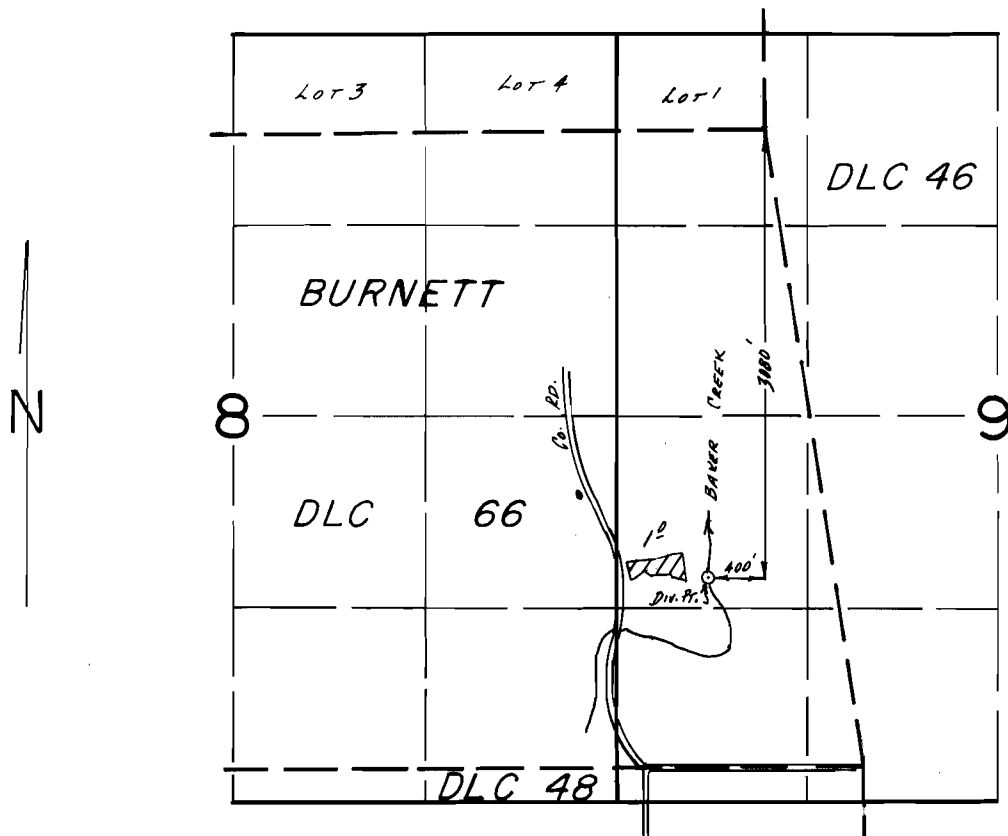

SCALE: 1" = 1320'

FINAL PROOF SURVEY
UNDER

Application No. 63854 Permit No. 47042
IN NAME OF

WILLIAM M. & CAROL L. BYERLEY

Surveyed Oct. 5 1987, by B. W. BISHOP