


T. 7 S., R. 3 W., W.M.

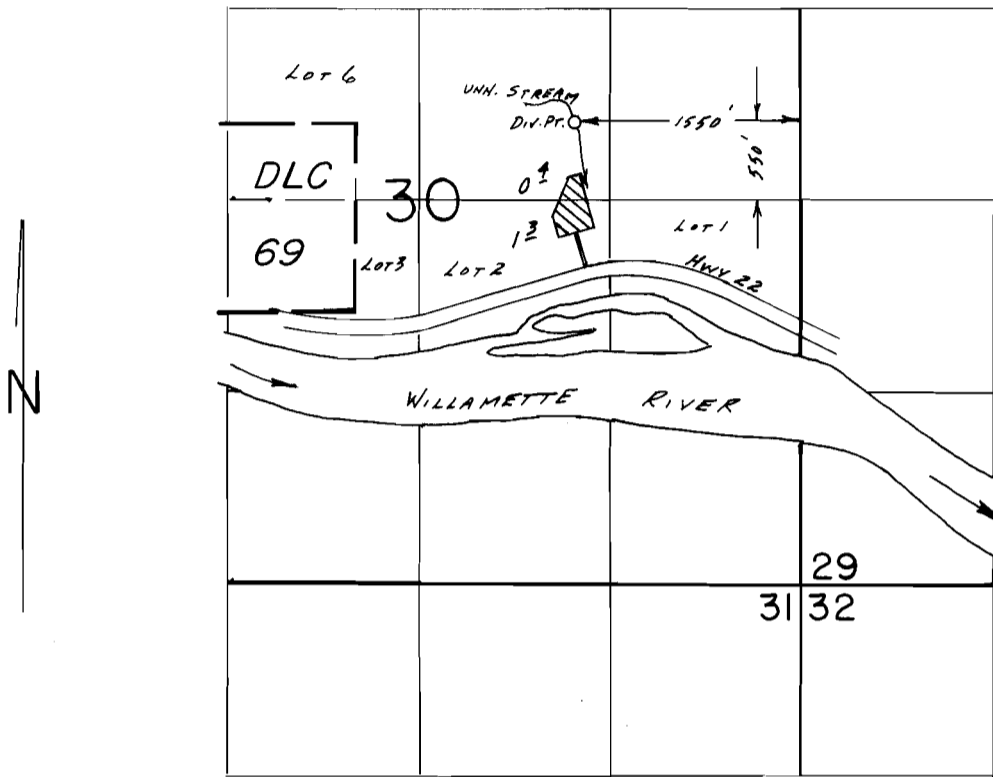

SCALE: 1" = 1320'

FINAL PROOF SURVEY
UNDER

Application No. 63816... Permit No. 47174.....
IN NAME OF

MAJOR A. ANDERSON

Surveyed June 3... 19.87, by B.W. BISHOP.....

3/27/89
BWB
41047-278-17L