


T. 3 S., R. 3 W., W. M.

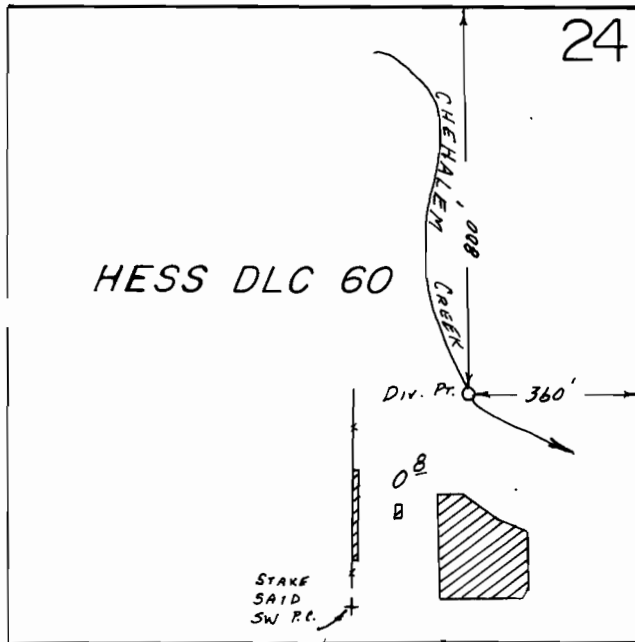

SCALE: 1" = 400'

FINAL PROOF SURVEY
UNDER

Application No. 63270. Permit No. 47510.....
IN NAME OF

.....CRAIG & ELIZABETH WASSON.....

Surveyed NOV. 9 1987, by B.W. BISHOP.....

3/4/89
PTS 1987-A *[Signature]*