


T.5S., R.3W., W.M.

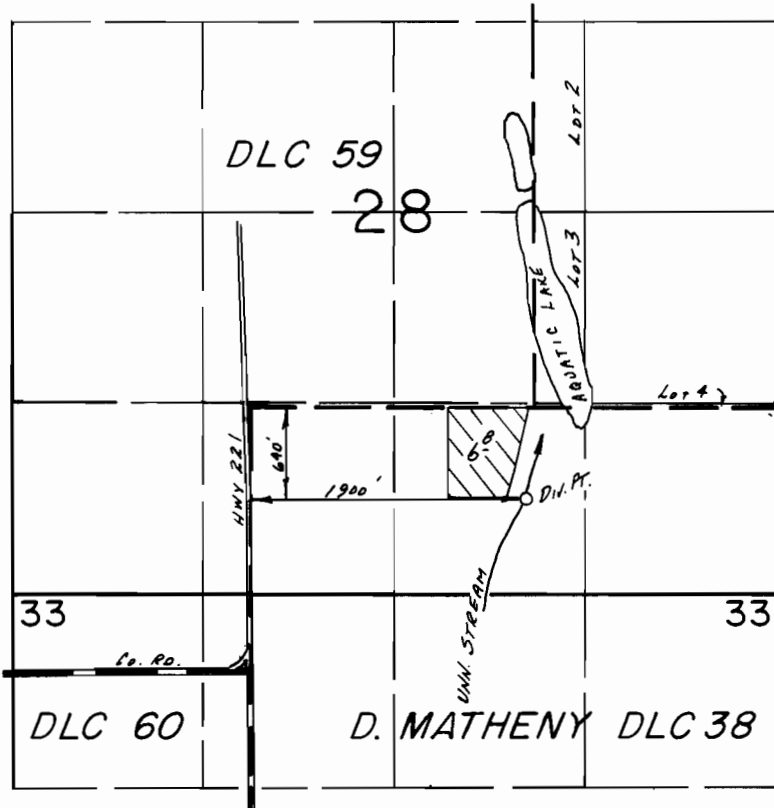

**FINAL PROOF SURVEY**  
UNDER

Application No. 65094. Permit No. 47564.....  
IN NAME OF

.....RICHARD JONES.....

Surveyed July 9..... 19.87, by ..B.W. BISHOP.....

3/7/89

4107-178-120R

AWB