


T. 10S., R. 3E., W.M.

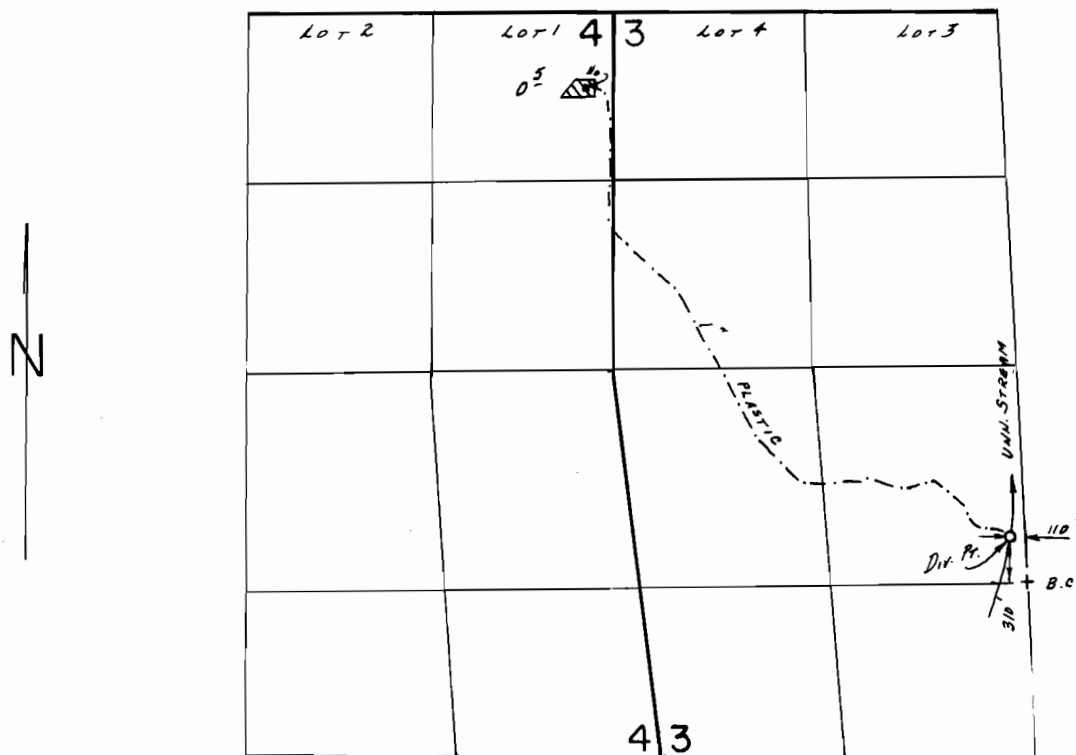

SCALE: 1" = 1320'

FINAL PROOF SURVEY

UNDER

Application No. 65137... Permit No. 47579....
IN NAME OF

RONNIE DEAN & CAROLYN D. DELKER

Surveyed June 18, 1986, by B.W. BISHOP.....