


T.3S., R.2W., W.M.

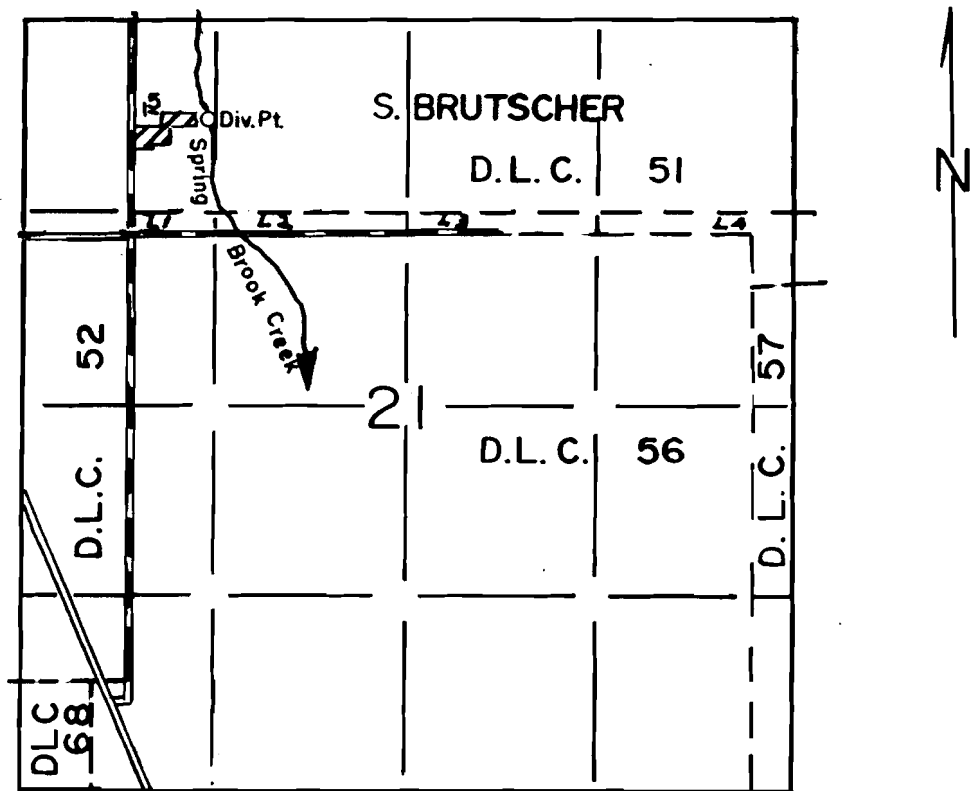

Div. Pt. Loc. 600' N. & 500' E. From The S.W. Cor. DLC 51

SCALE: 1" = 1320'

### FINAL PROOF SURVEY UNDER

Application No. 66099. Permit No. 48076.....  
IN NAME OF

MARJORIE JOAN DICKIE.....

Surveyed JULY 24 1987, by B.W. BISHOP.....