


T. 3 S., R. 3 W., W. M.

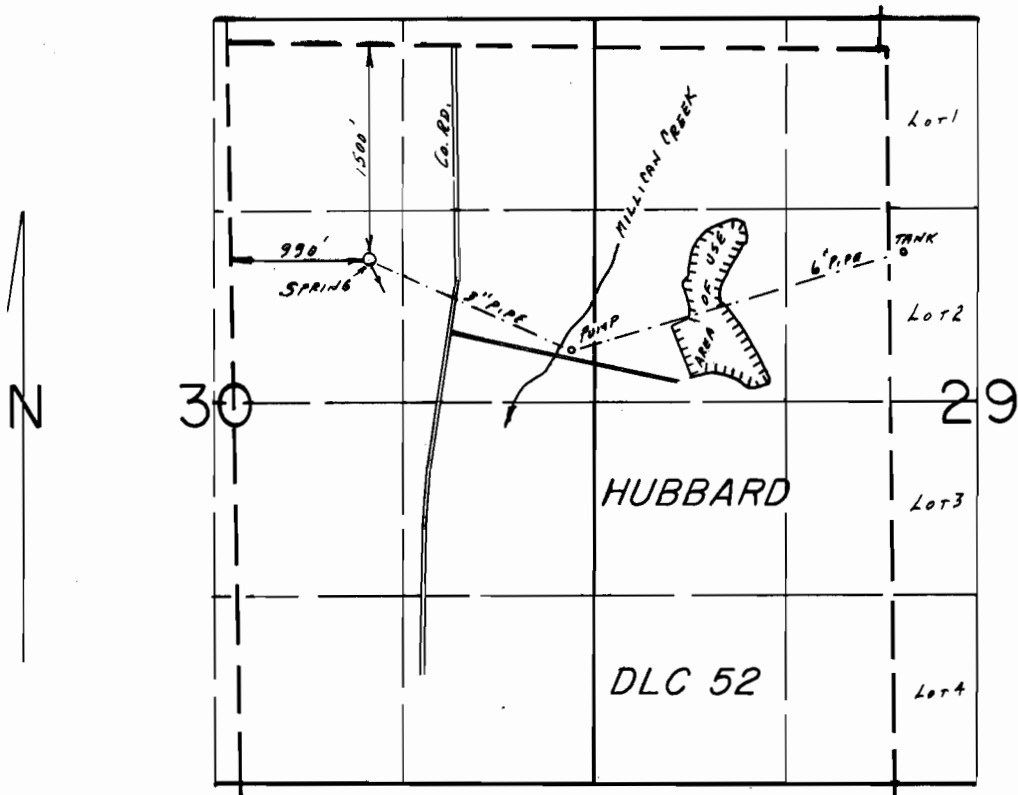

SCALE: 1" = 1320'

FINAL PROOF SURVEY
UNDER

Application No. 67947 Permit No. 48343
IN NAME OF

OUR LADY OF GUADALUPE TRAPPIST MONASTERY

Surveyed Sept. 17 1987, by B. W. BISHOP

3/7/89
41071-178-114R BWS