


T. 6 S., R. 6 W., W. M.

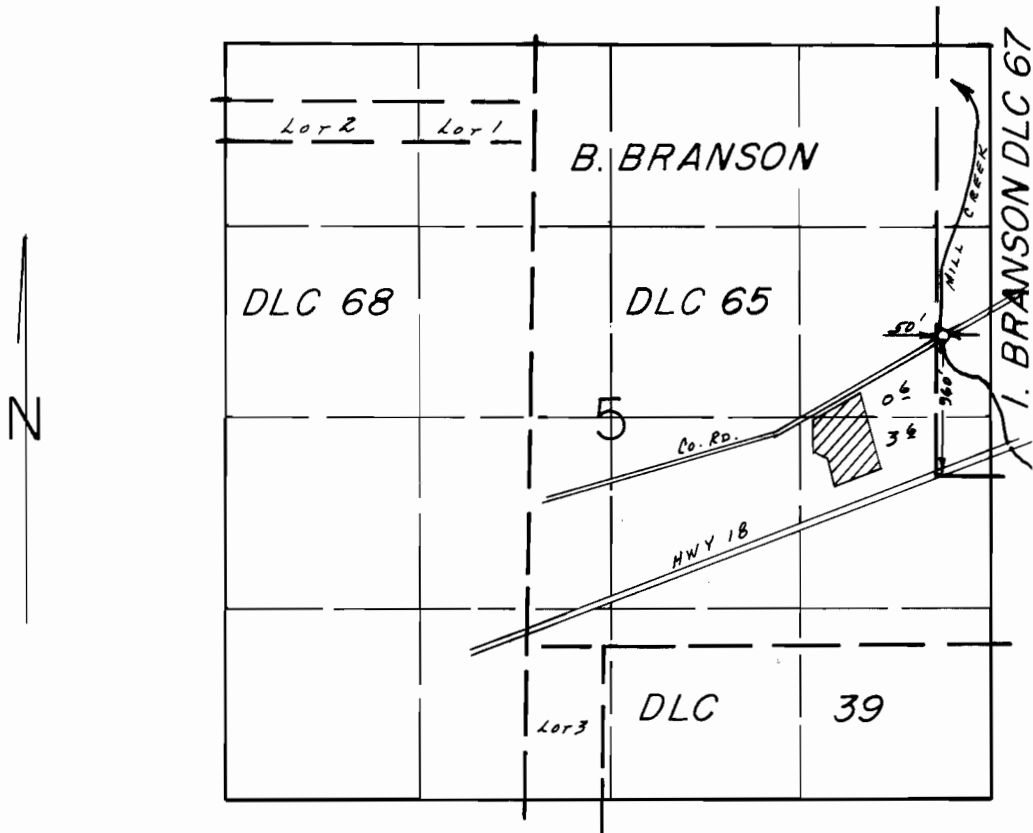

SCALE: 1" = 1320'

FINAL PROOF SURVEY
UNDER

Application No. 68457 Permit No. 49443
IN NAME OF

WILLIAM JOSEPH & CAROLL KELLER

Surveyed Oct. 5 1987, by B. W. BISHOP