


T. 3 S., R. 4 W., W.M.

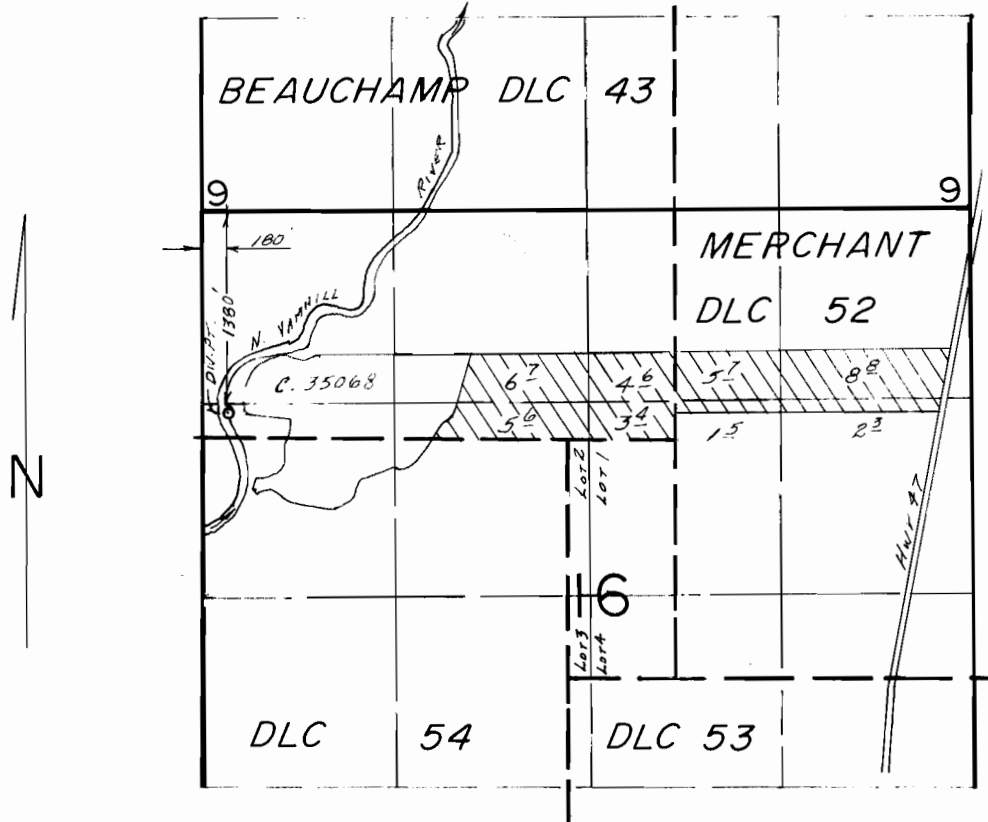

SCALE: 1" = 1320'

FINAL PROOF SURVEY UNDER

Application No. 69119... Permit No. 50040.....

IN NAME OF

HARVEY & KATHERINE GERMAN

Surveyed Oct. 7..... 19.87, by B.W. BISHOP.....