


T. 36 S., R. 5 W., W. M.

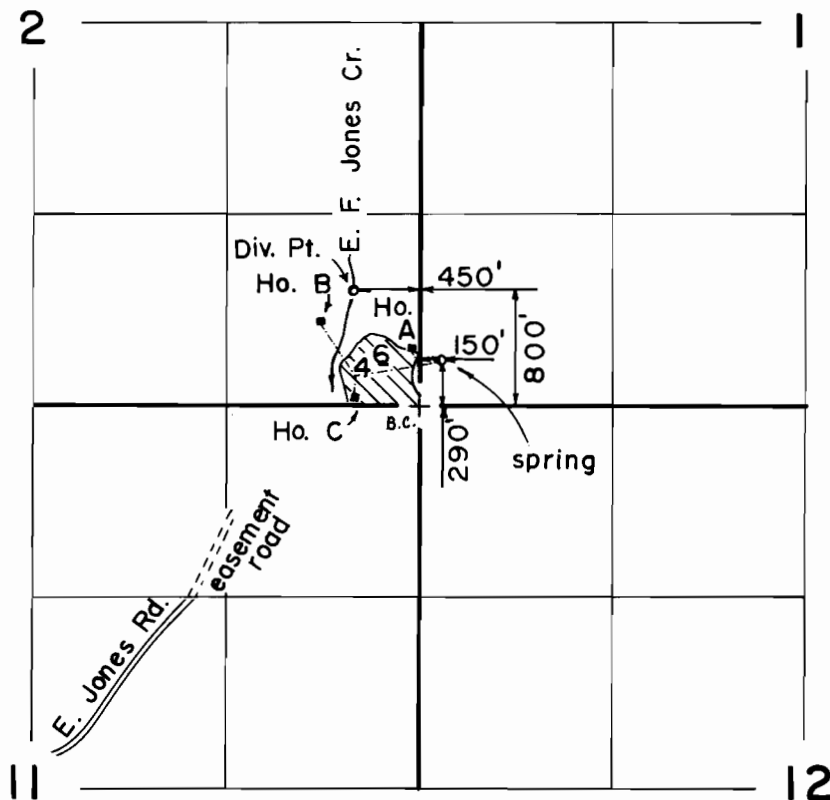

Scale: 1" = 1320'

FINAL PROOF SURVEY UNDER

Application No. 48640 Permit No. 36485.
IN NAME OF

.....WILMA WHITMER.....

Surveyed AUG. 20 1987, by B. S. JAMES.