


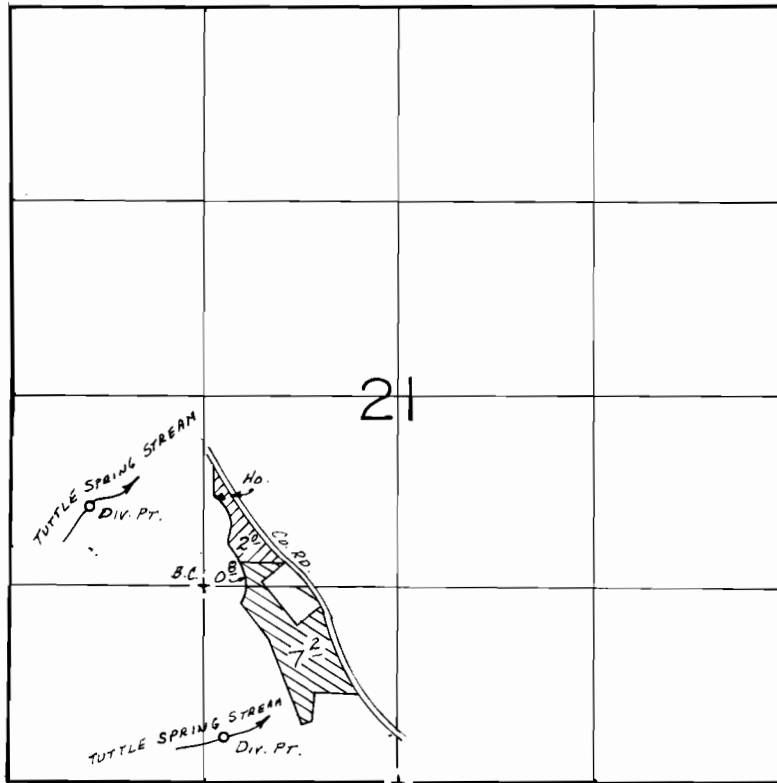

 Tr. 2901
 Tr. 3050

FINAL PROOF SURVEY

UNDER

Transfer Nos. 2901 & 3050

IN NAME OF

.....LOWELL F. CAMP.....

Surveyed Nov. 6, 1984, by J.R. WOODROOF.