


# T.2S., R.3W., W.M

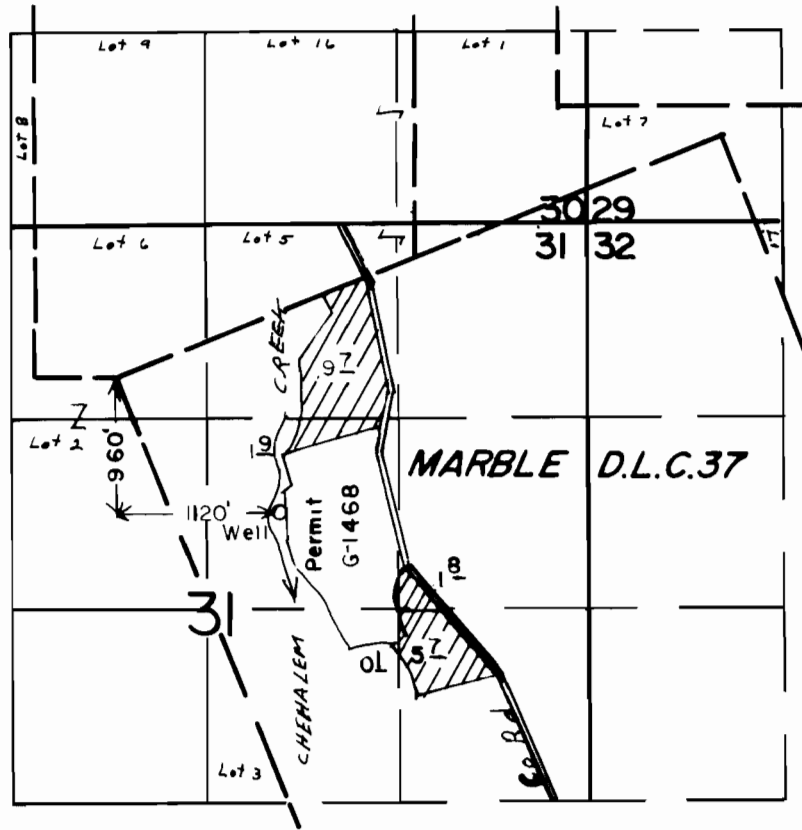

## FINAL PROOF SURVEY UNDER

Application No. ~~G-5972~~ Permit No. ~~G-5213~~.....  
IN NAME OF

MARVIN GEORGE NAGELY

Surveyed OCT. 13 1987, by B.W. BISHOP.....