


T. 17 & 18S., R. 40 & 41E., W.M.

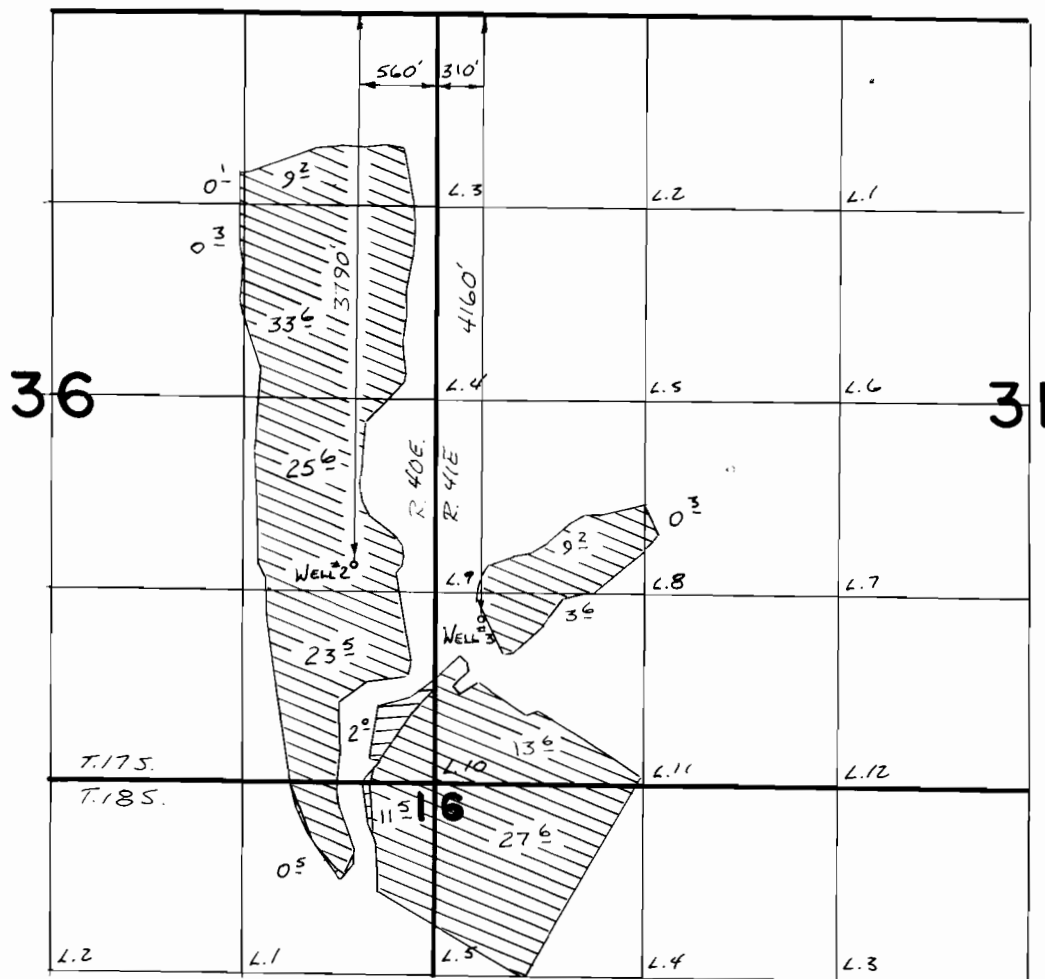

Prim.



Suppl.



FINAL PROOF SURVEY UNDER

SCALE 1"=1320'

Application No. **G:7579** Permit No. **G:7089**
IN NAME OF

JORDAN CATTLE CO.

Surveyed **5-24** 1988, by **V.L. Church**