


T. 27S., R. 34 & 35E., W.M.

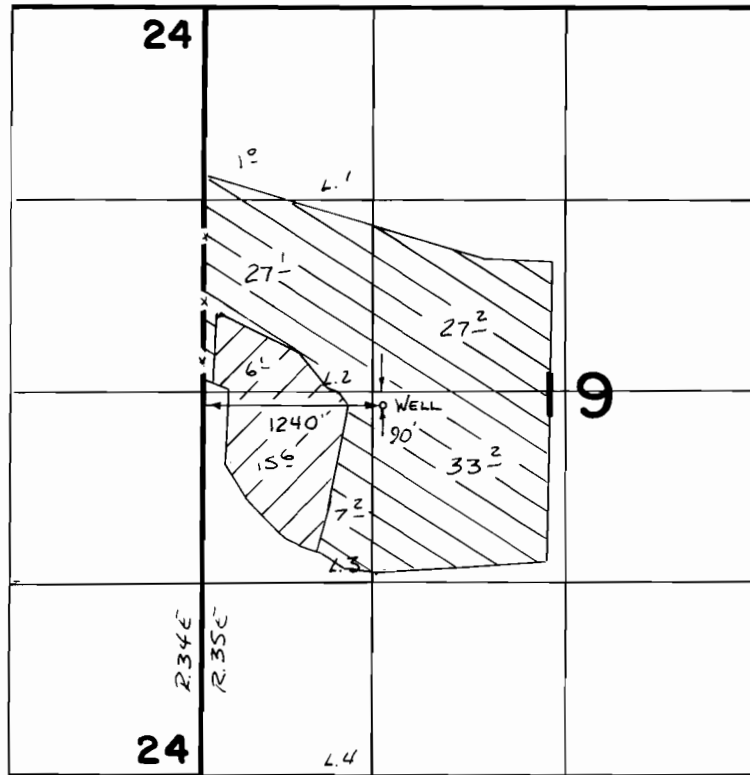

SCALE 1" = 1320



PRIM



SUPPL

FINAL PROOF SURVEY

UNDER

Application No. **G:8257** Permit No. **G:7636**
IN NAME OF

V-DASH CATTLE CO.

Surveyed **5-10** 19**88**, by **J.M. WARREN**