
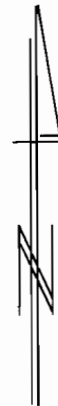


T1S, R2E, WM

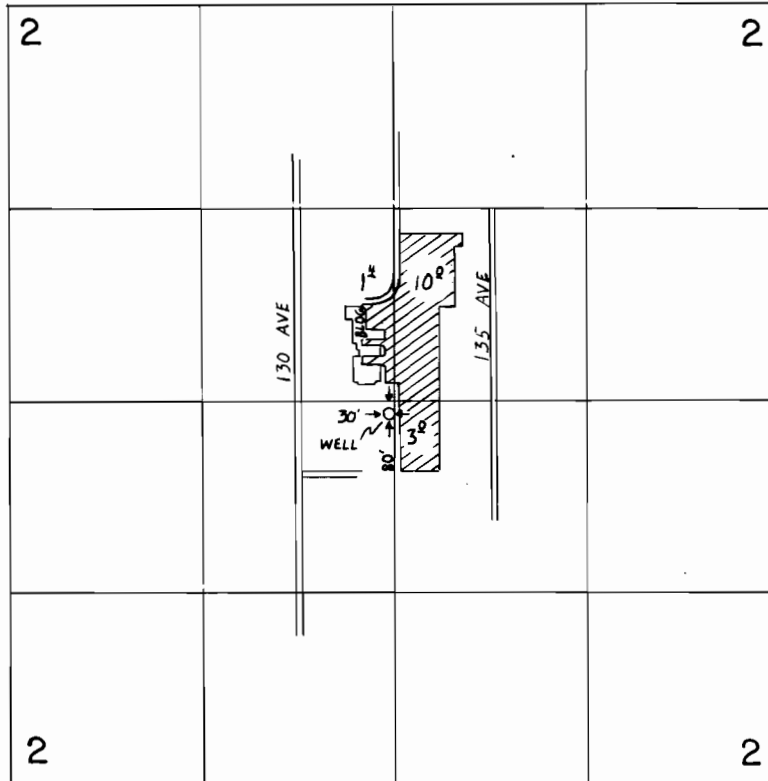

1" = 1320

FINAL PROOF SURVEY UNDER

Application No. G-8260 Permit No. G-7.6.7.6...
IN NAME OF

DAVID DOUGLAS PUBLIC SCHOOLS

MAY 2 84 P. R. PAGTER
Surveyed MAY... 1987., by T. M. WARREN...