


T. 13S., R. 5W., W.M.

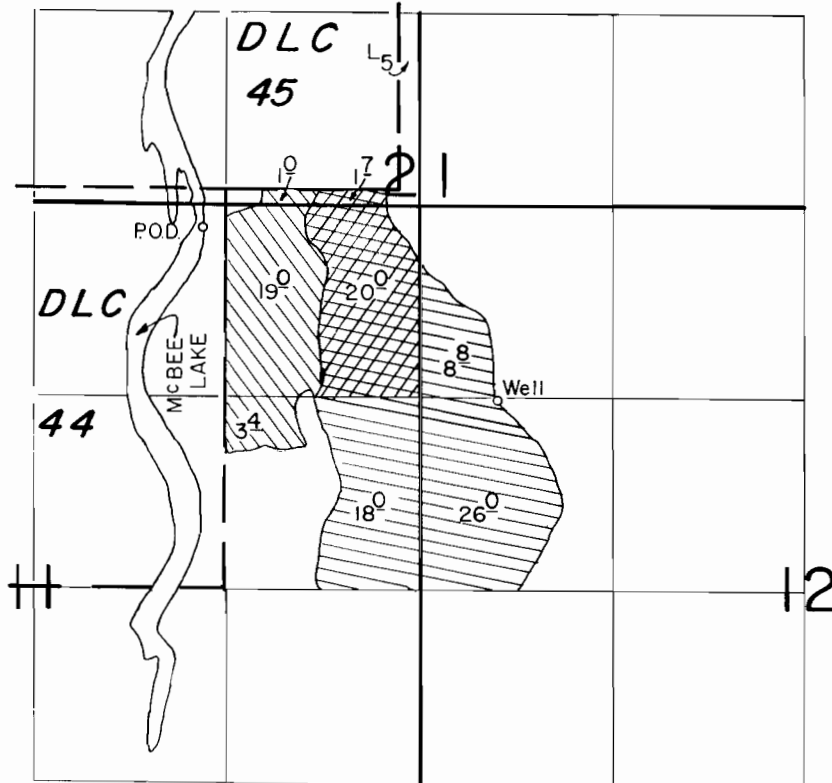

P.O.D. Loc.: 250' S. & 1340' W.

Well Loc.: 1440' S. & 680', both from SW Cor. DLC 45.

Scale: 1" = 1320'

FINAL PROOF SURVEY UNDER

G - 8288

G-7668



Application No. 59425 Permit No. 44671

IN NAME OF

BOBB F. BROWN

Surveyed NOV. 23. 1987., by T. Warren