90684

T.2&3S., R.3&4W., W.M.

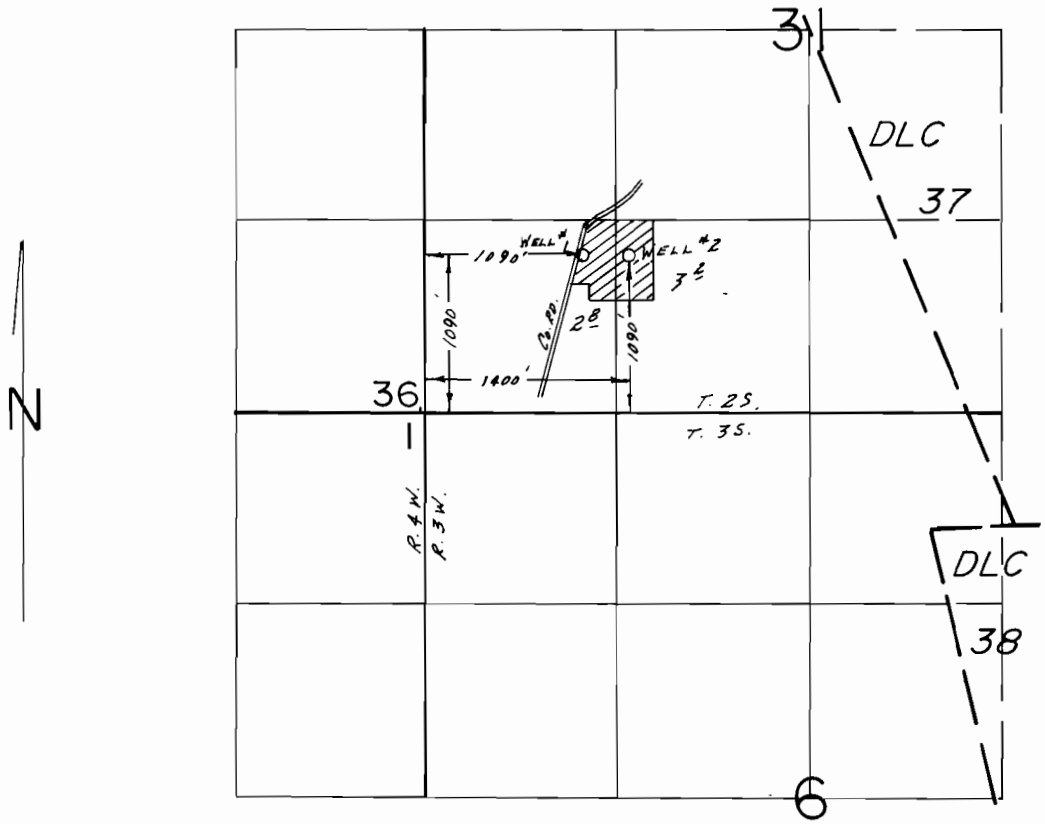

SCALE: 1" = 1320'

FINAL PROOF SURVEY
UNDER

Application No. G-8394 Permit No. G-7785
IN NAME OF

MARY A. REEVES

Surveyed July 28 1987, by B.W. BISHOP

3/21/89
41071-178-112L