


T.16S.,R.4W.,W.M.

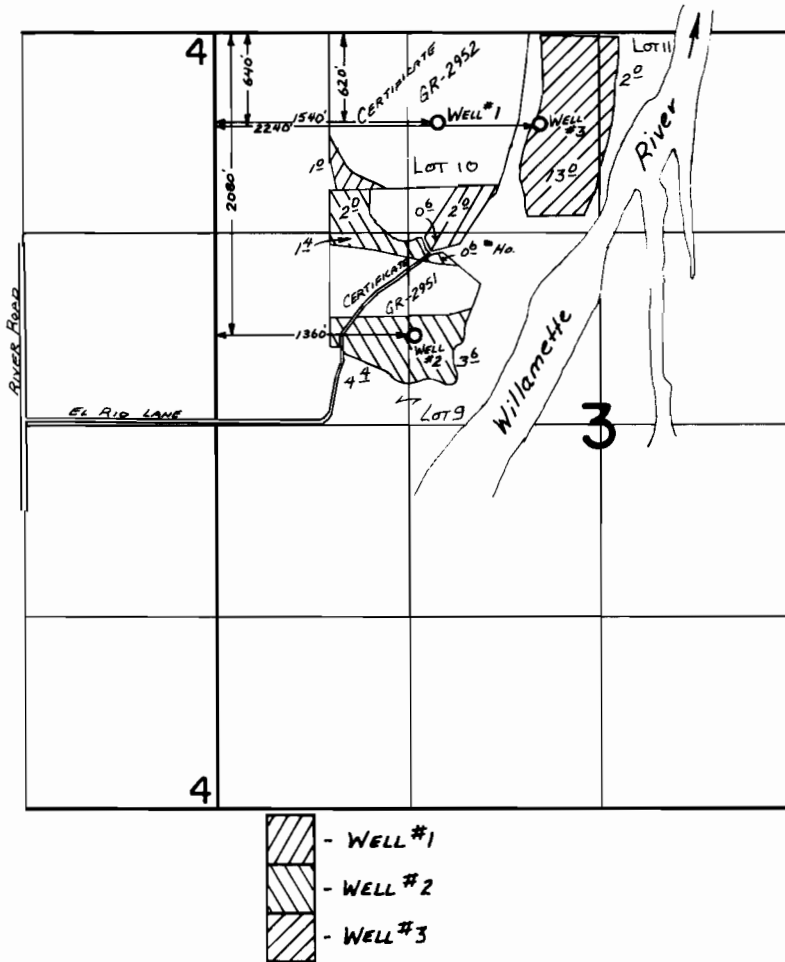

FINAL PROOF SURVEY UNDER

Application No. G-9109 Permit No. G-8479
IN NAME OF

RAYMOND H. BLOOD FARMS, INC.

Surveyed June 16, 1982, by L. M. TOLL