


T. 2 N., R. 4 W., W.M.

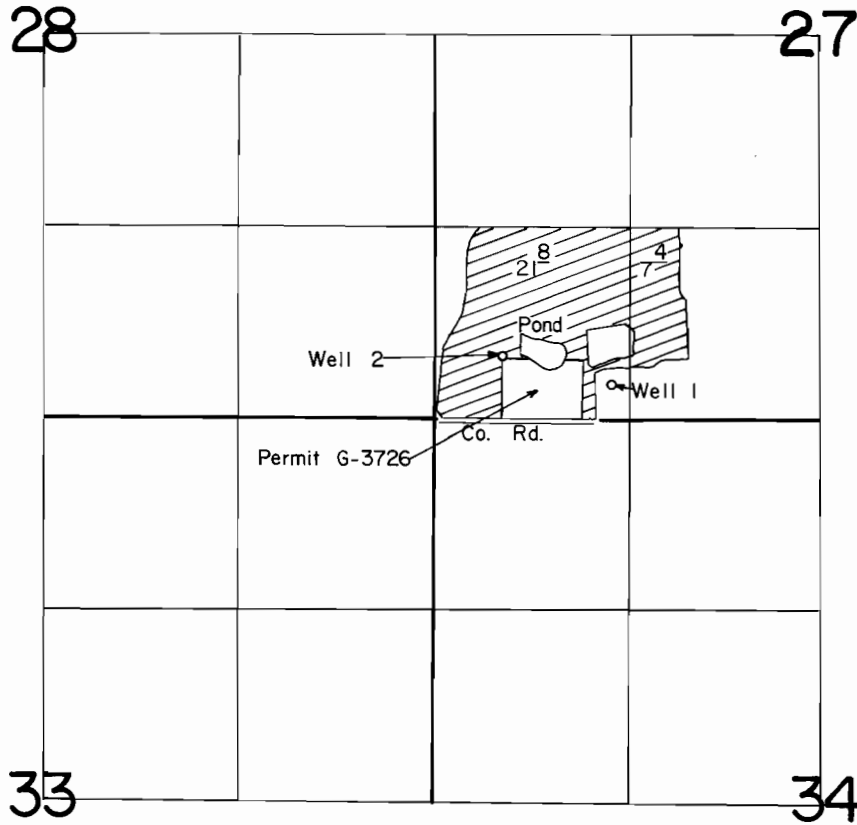

Well 1 Loc. : 230' N. & 1210' E.
 Well 2 Loc. : 450' N. & 470' E., both from SW Cor., Sec. 27.

Scale: 1" = 1320

FINAL PROOF SURVEY UNDER

Application No. G-9197... Permit No. G-8560...
 IN NAME OF

JAMES E. NEWGARD

Surveyed May 20 1987, by Ben Bishop