


T. 4 S. R. 3 W. W.M.

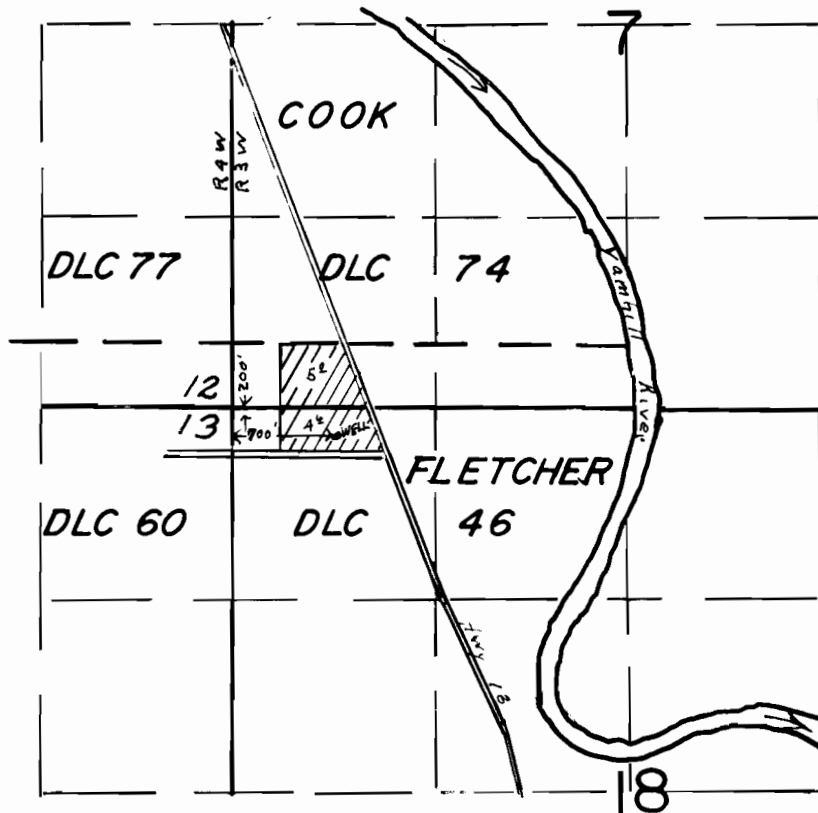

SCALE: 1" = 132.0'

FINAL PROOF SURVEY
UNDER

Application No. G-10732. Permit No. G-9768....
IN NAME OF

CLAUDE & GAYNELLE HENDERSON

Surveyed JULY 20, 1987., by B.W.BISHOP.....