


T. 7 S., R. 5 W., W. M.

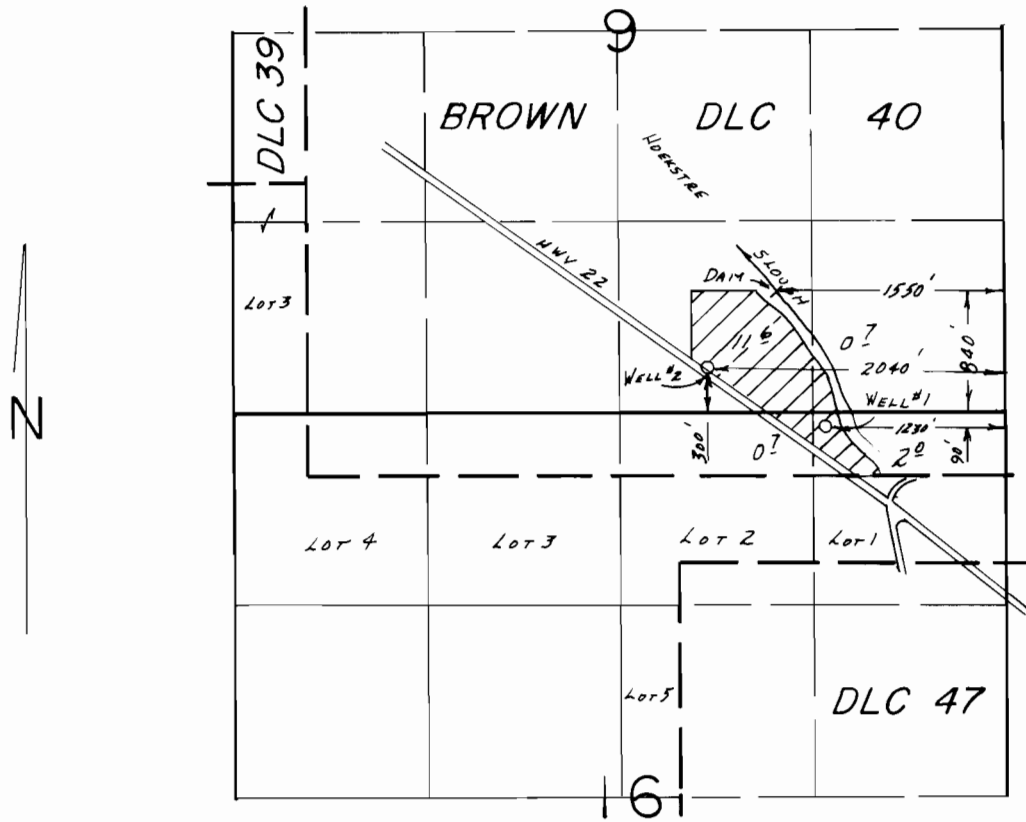

SCALE: 1" = 1320'

**FINAL PROOF SURVEY**  
UNDER

R-63623	R-8460
63624	46837
Application No. G-10750	Permit No. G-9822

IN NAME OF

.....DONALD TRUSSELL.....

Surveyed May 1, 1987, by B.W. BISHOP