


T. 7 S., R. 5 W., W. M.

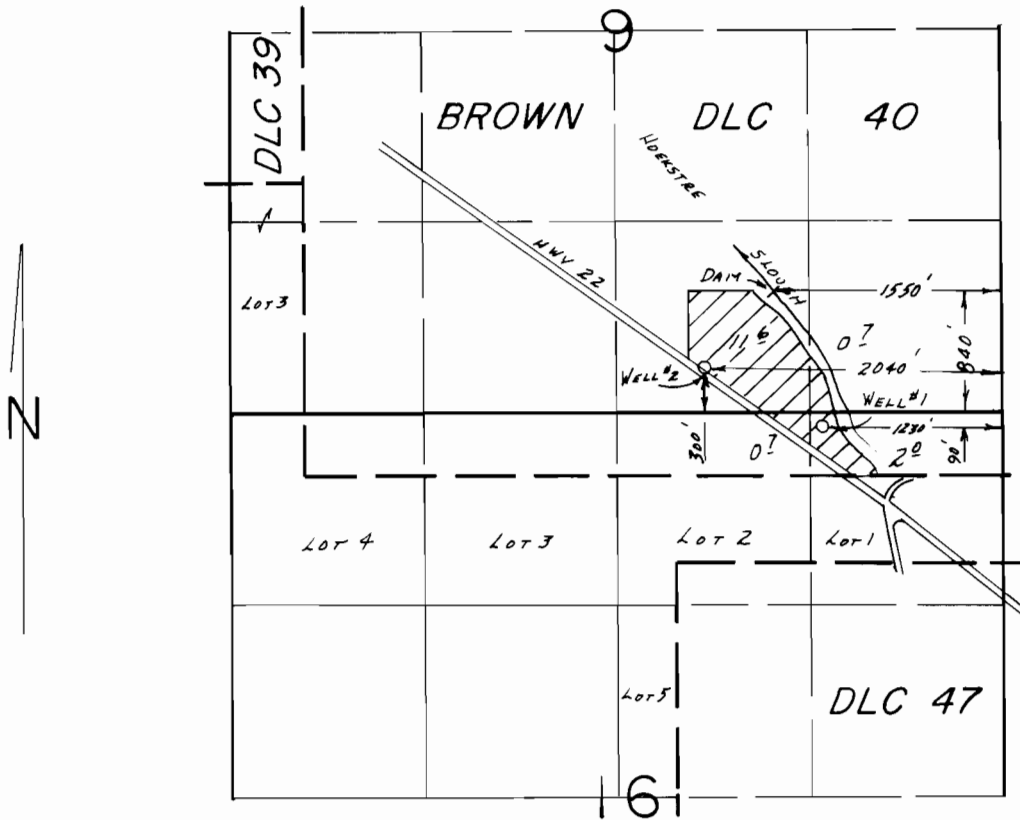

SCALE: 1" = 1320'

FINAL PROOF SURVEY UNDER

R-63623 R-8460
63624 46837

Application No. G-10750 Permit No. G-9822
IN NAME OF

.....DONALD TRUSSELL.....

Surveyed May 1, 1987, by B.W. BISHOP