


T.138 & 14S., R.5W., W.M.

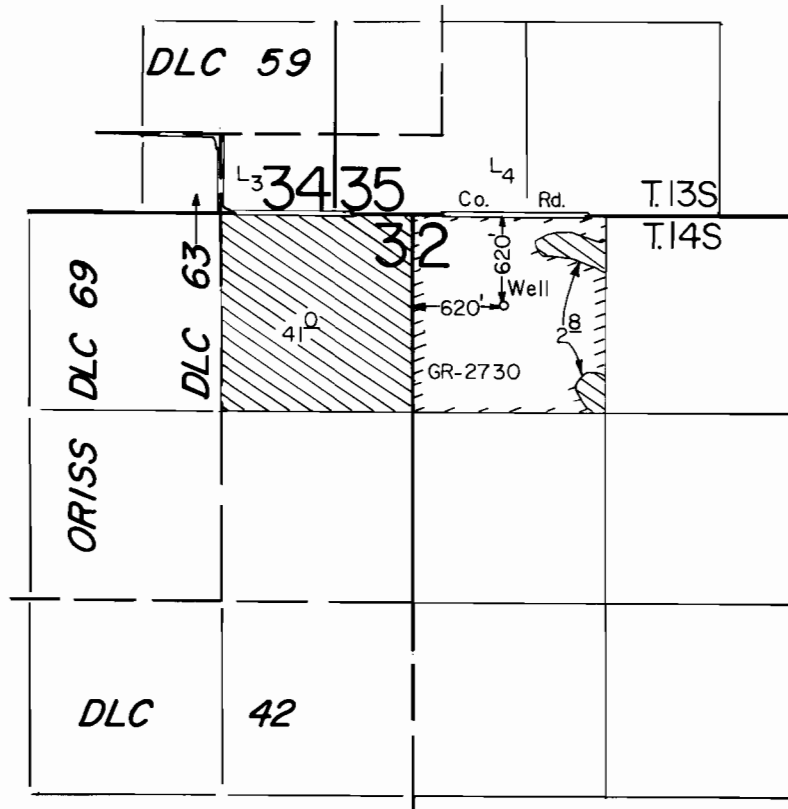

Scale : 1" = 1320'

**FINAL PROOF SURVEY**  
UNDER

Application No. G-10963. Permit No. G-10064.....

IN NAME OF

**GEORGE HORNING**

Surveyed Sept. 25, 1987., by T. Warren.....