


T. 14 S., R. 5W., W.M.

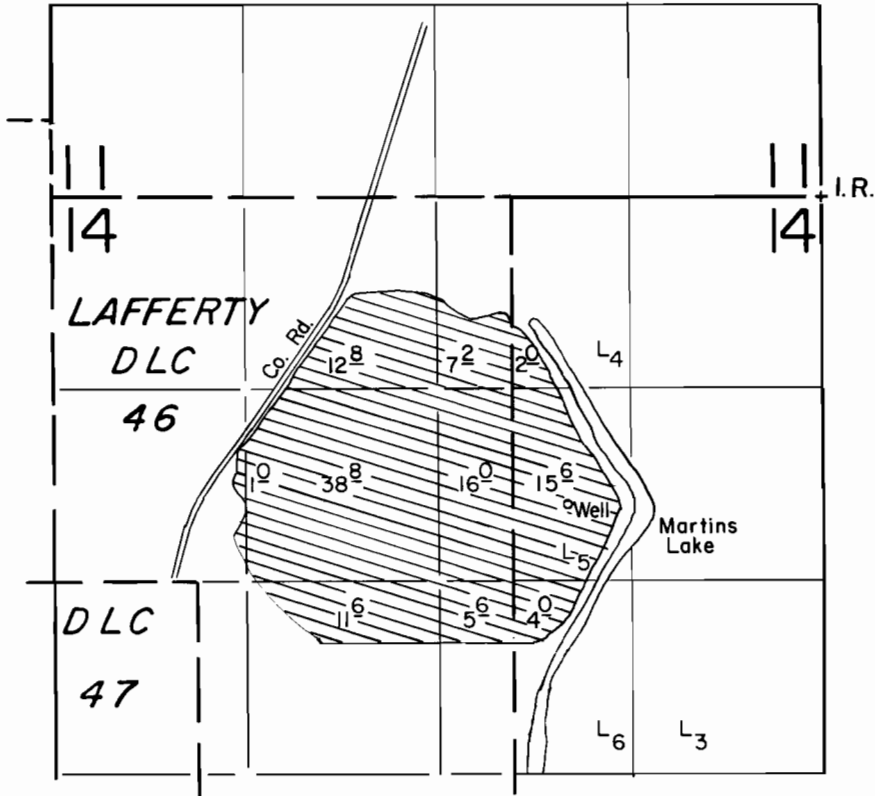

Well Loc.: 2100' S. & 1720' W. from NE Cor. Sec. 14

Scale : 1" = 1320'

FINAL PROOF SURVEY
UNDER

Application No. G-11066 Permit No. G-10216...
IN NAME OF

GEORGE HORNING

Surveyed Sept. 25, 1987, by T. Warren.....