


G10230

L1884

T.2N., R.32E., W.M.

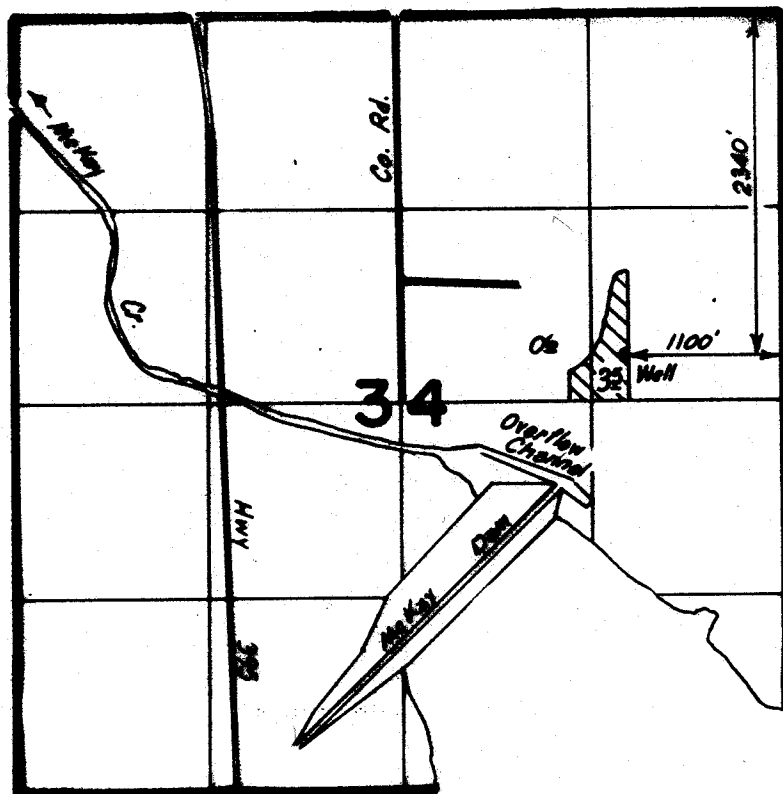

FINAL PROOF SURVEY UNDER

Scale: 1" = 1320'

Application No. G11075.. Permit No. G10230...
IN NAME OF

.....CLELEN F. DUDEK.....

Surveyed ..11-3..... 1988., by ..Vern..Church...