


T. 4 S., R. 4 E., WM

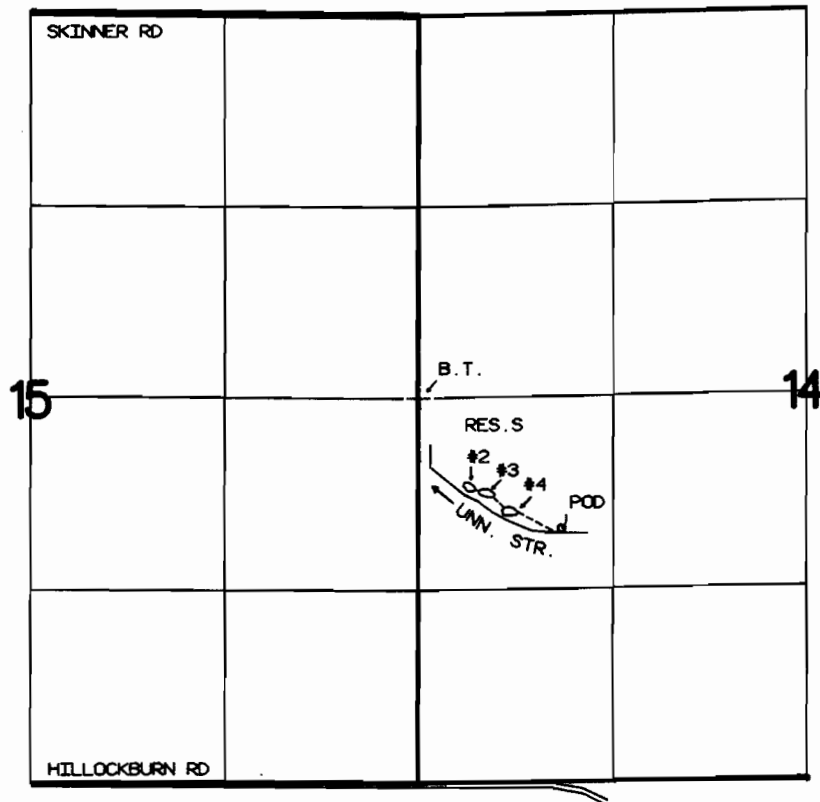

1" = 1320 FT

POD LOCATION: 970 FT S AND 940
FT E FROM THE W 1/4 CORNER 14

FINAL PROOF SURVEY
UNDER

R-52982 R-6124
Application No.: 52983 Permit No.: 37842

IN THE NAME OF

ARTHUR T. HIMM

Surveyed: JULY 20, 1987

By: T. M. WARREN

RWK
41005 278 200L