


T. 4 S., R. 4 E., WM

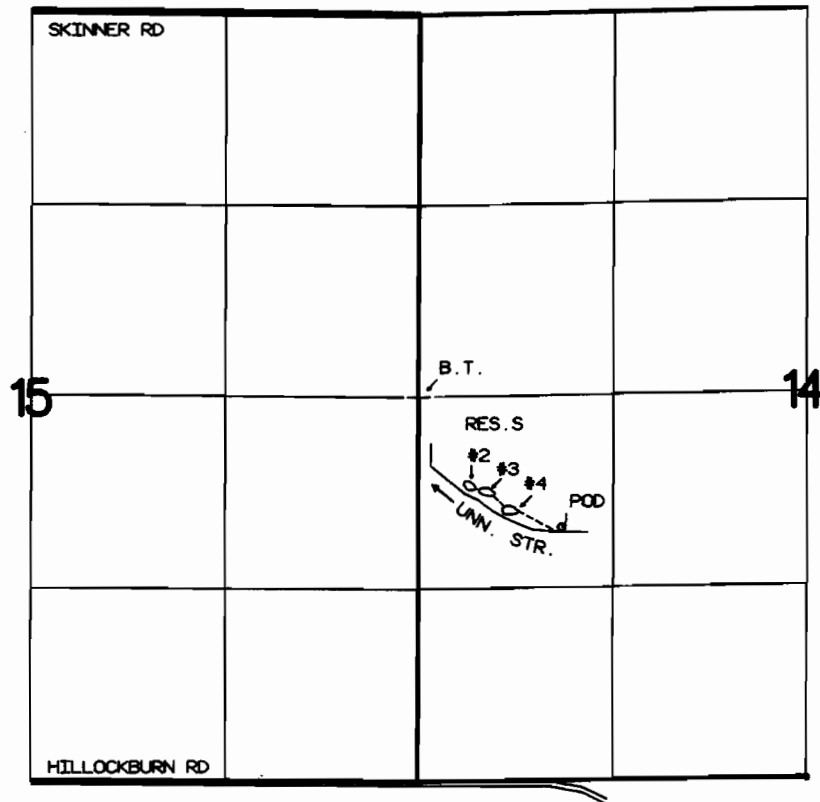

POD LOCATION: 970 FT S AND 940
FT E FROM THE W 1/4 CORNER 14

FINAL PROOF SURVEY
UNDER

Application No.: R-52982 52983 Permit No.: R-6124 37842

IN THE NAME OF
ARTHUR T. HIMM

Surveyed: JULY 20, 1987

By: T. M. WARREN