


T. 2 S., R. 3 W., W. M.

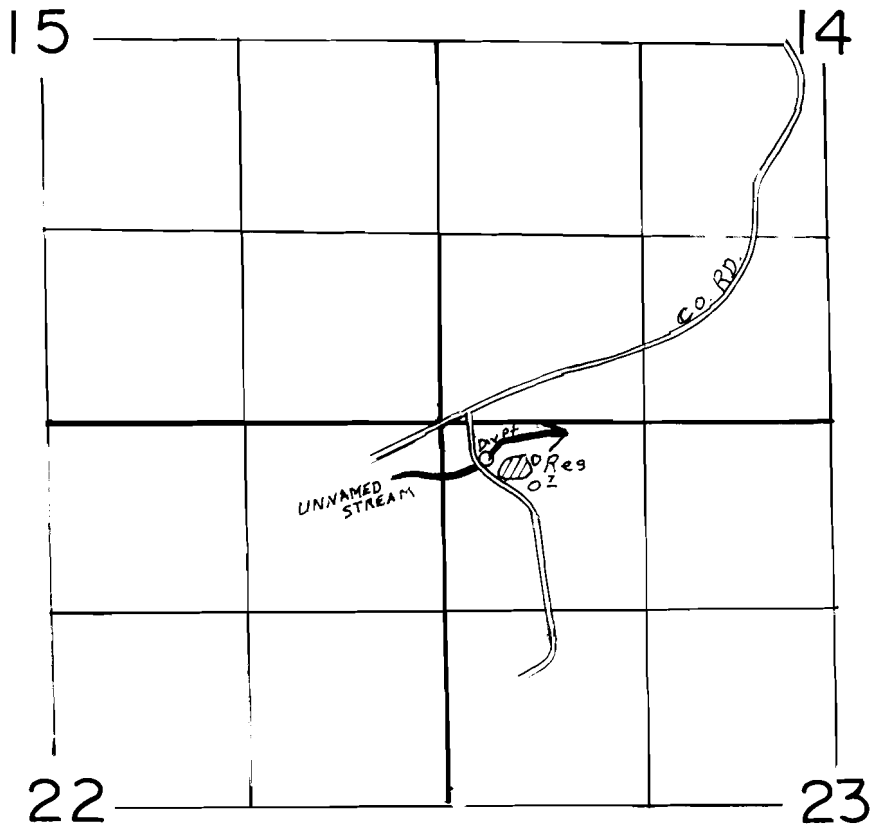

DIV PT LOCATED 250'S & 240'E FROM THE N.W. COR SEC 23

SCALE: 1" = 1320'

FINAL PROOF SURVEY
UNDER

R-55617 R-6730

Application No. 55618... Permit No. 42467.....

IN NAME OF

..... JOHN GEIS

Surveyed JULY 28, 1987., by B.W. BISHOP.....