


T.16S. R.2E. W.M.

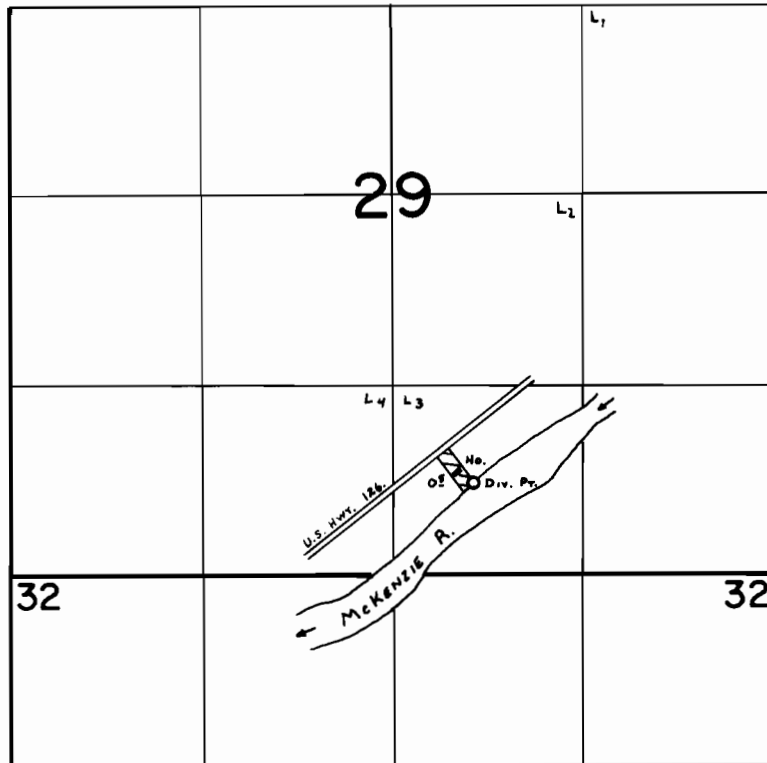

Div. Pt. Loc: 670'S. & 550'E. fr. N.W. Cor. Lot 3 Sec. 29.

**FINAL PROOF SURVEY**  
UNDER

Application No. 46999. Permit No. 34786.....  
IN NAME OF

.....**ROGER R. CRIST**.....

Surveyed Sept. 11, 1979, by C. L. HUGHES.....