


T. 13S., R. 6W., W.M.

Section 6

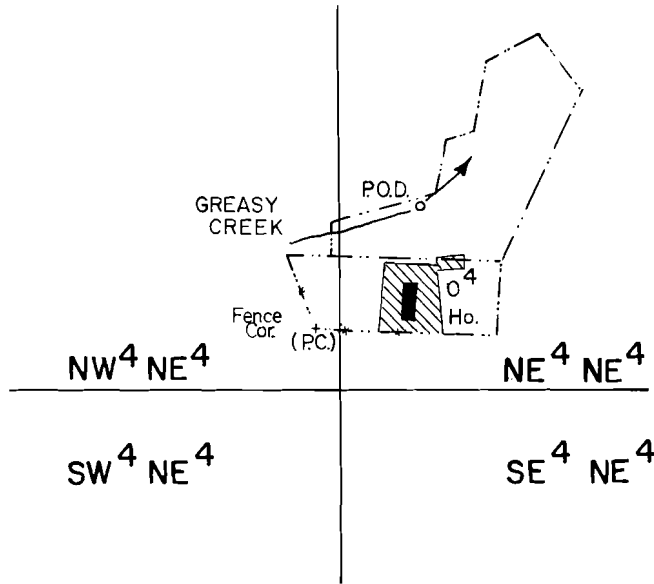

P.O.D. Loc.: 380' N. & 170' E. from SW Cor. NE⁴NE⁴ Sec. 6.

Scale: 1" = 400'

FINAL PROOF SURVEY
UNDER

Application No. 50350 Permit No. 38010
IN NAME OF

BRET & JANICE McMACKIN

Surveyed May 29, 1980, by Chris Hughes
& May 5, 1987, by T. Warren