


T.5S., R.6W., W.M.

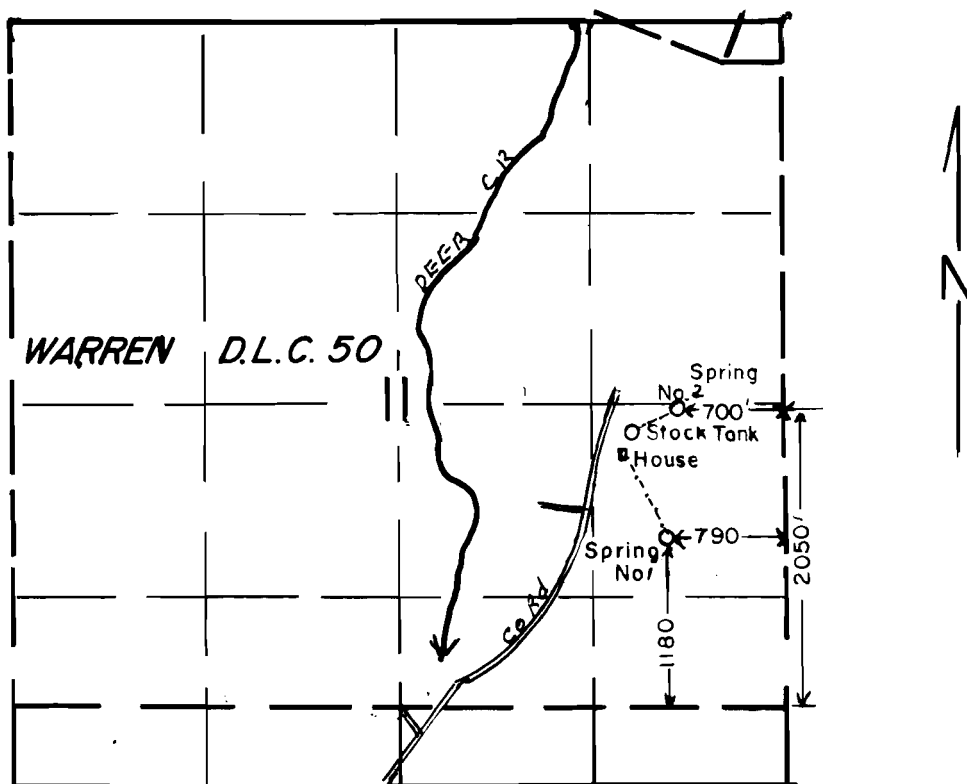

SCALE: 1"=1320'

FINAL PROOF SURVEY UNDER

Application No. **53973**.. Permit No. **40254**.....
IN NAME OF

VERN G. & CHARLETE CLEMMER.....

Surveyed JULY.6..... 1987.., by B.W.BISHOP.....