


T. 16S., R. 9W., W.M.

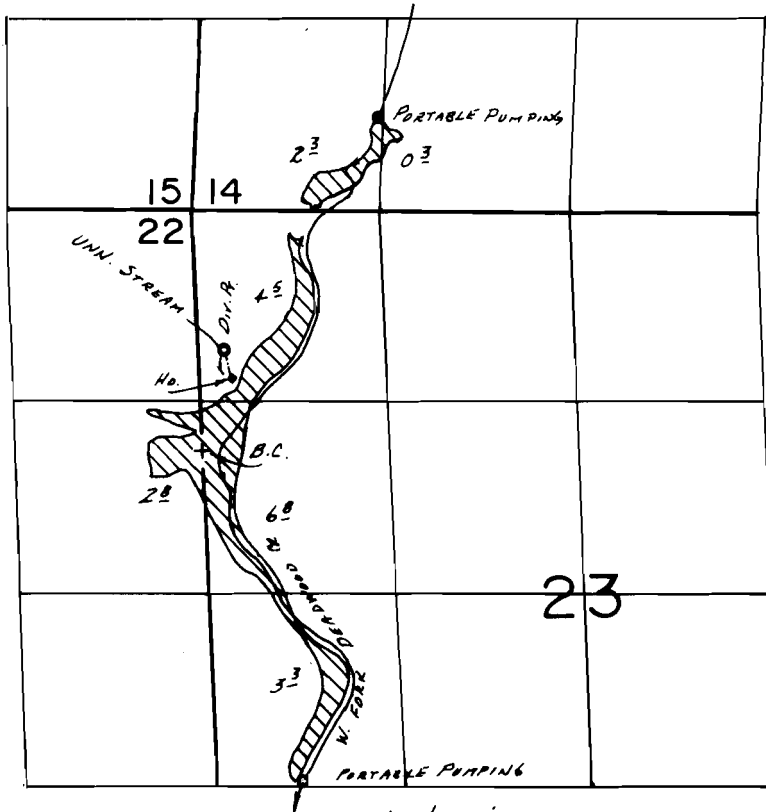

DIV. PYS. LOC.: DOMESTIC - 950'S. & 210'E.; IRRIGATION - PORTABLE PUMPING BETWEEN 640'N. & 1270'E. & 3920'S. & 780'E., ALL FROM NW COR. SEC. 23.

SCALE: 1" = 1320'

## FINAL PROOF SURVEY UNDER

Application No. 54024. Permit No. 40840...  
IN NAME OF

.....THOMAS R. ALEXANDER.....

Surveyed June 6.... 19.84, by P.R. PAGTER.....  
July 30 1986 B.W. BISHOP

1-20-87 BwB

41039-178-88R