


T. 14 S., R. 5 W., W.M.

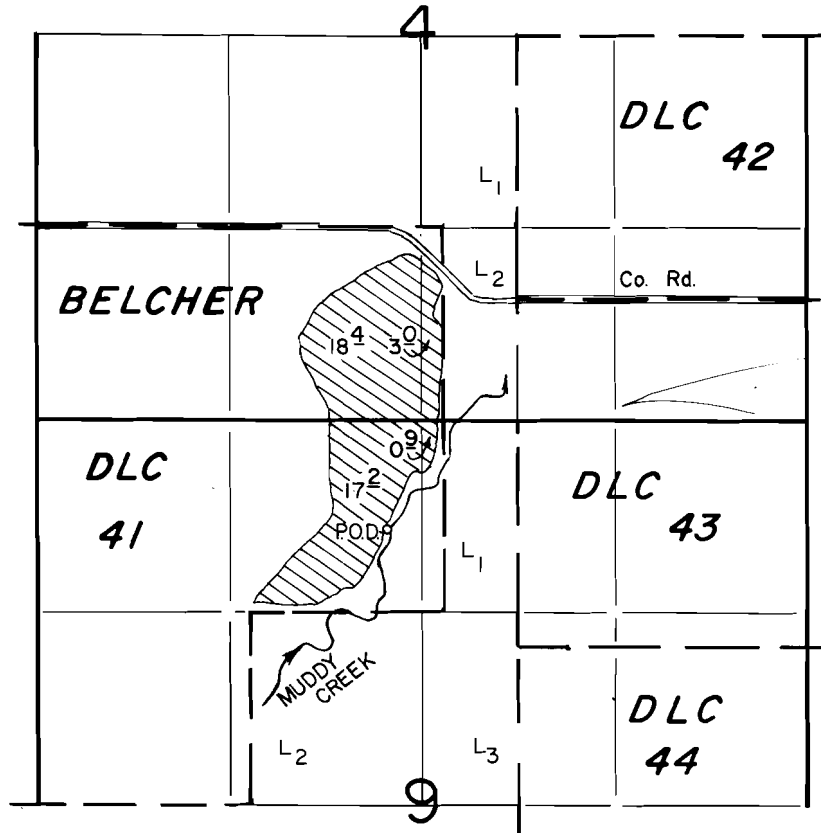

P.O.D. Loc. : 2060' S. & 380' W. from NE Cor. DLC 41

Scale : 1" = 1320'

FINAL PROOF SURVEY
UNDER

Application No. 54618 Permit No. 40981
IN NAME OF

J & C. HUNT CLUB, INC.

Surveyed AUG. 13. 1987, by T. Warren