


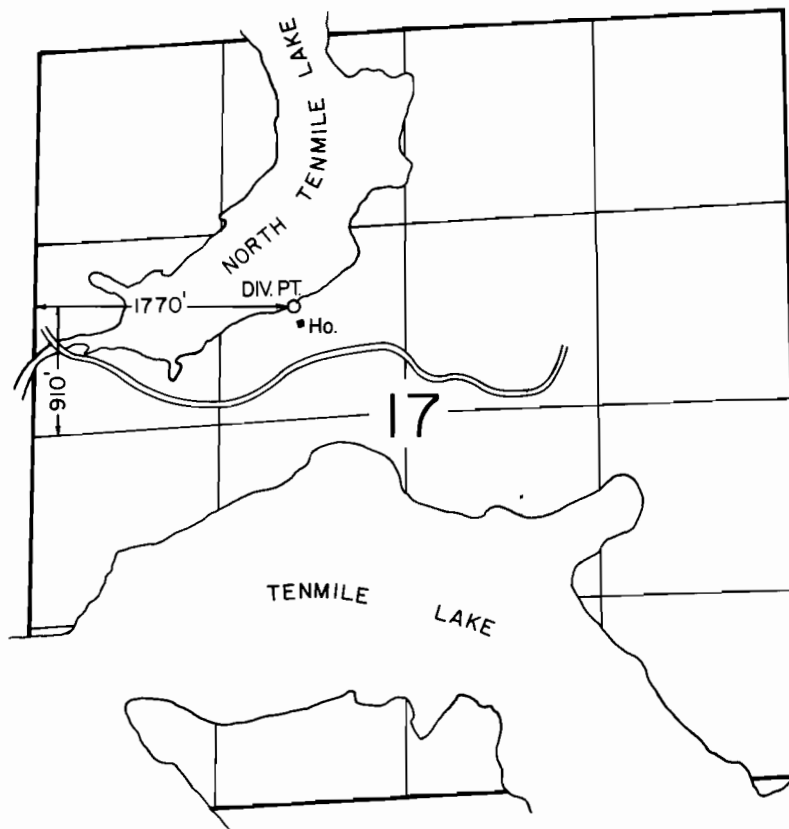

T 23 S., R. 12 W., W.M.



SCALE: 1" = 1320'

FINAL PROOF SURVEY UNDER

Application No. 54760.. Permit No. 41077.....
IN NAME OF

.....RALPH E. HATCH.....

Surveyed SEPT. 19. 1988, by L.M. JOACHIMS