


T. 39 S., R. 5 W., W.M.

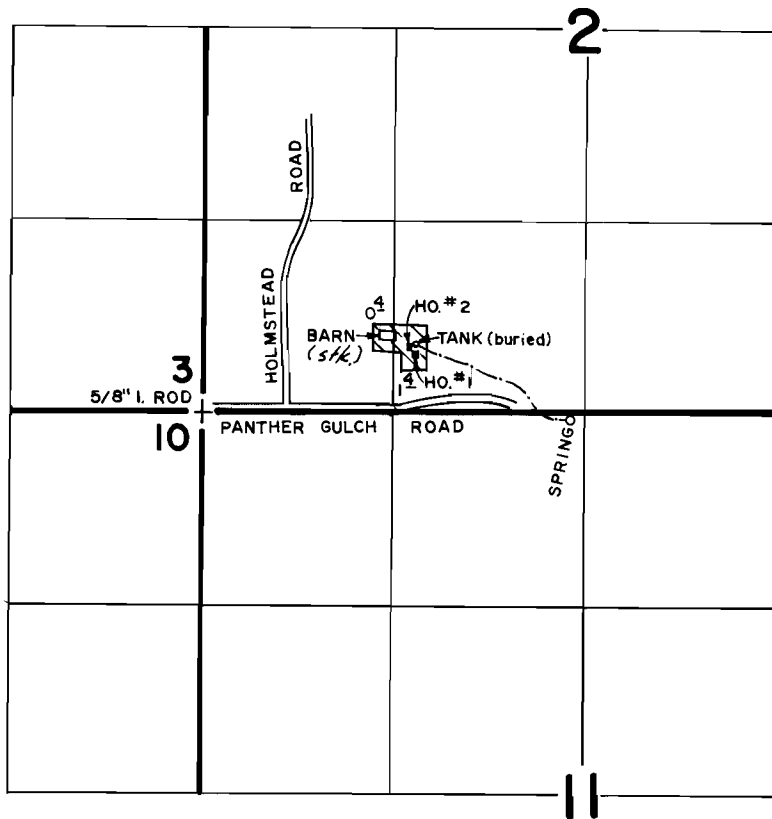

SPRING: 50' S. & 100' W. from S. 1/4 COR. SEC. 2

FINAL PROOF SURVEY
UNDER

Application No. 55731 Permit No. 41741
IN NAME OF

JEANINE BUCKLEY

Surveyed AUG. 11 1983, by B. SUZIE JAMES

SCALE: 4" = 1 MILE