


T. 38 & 4 S., R. 2 W., W.M.

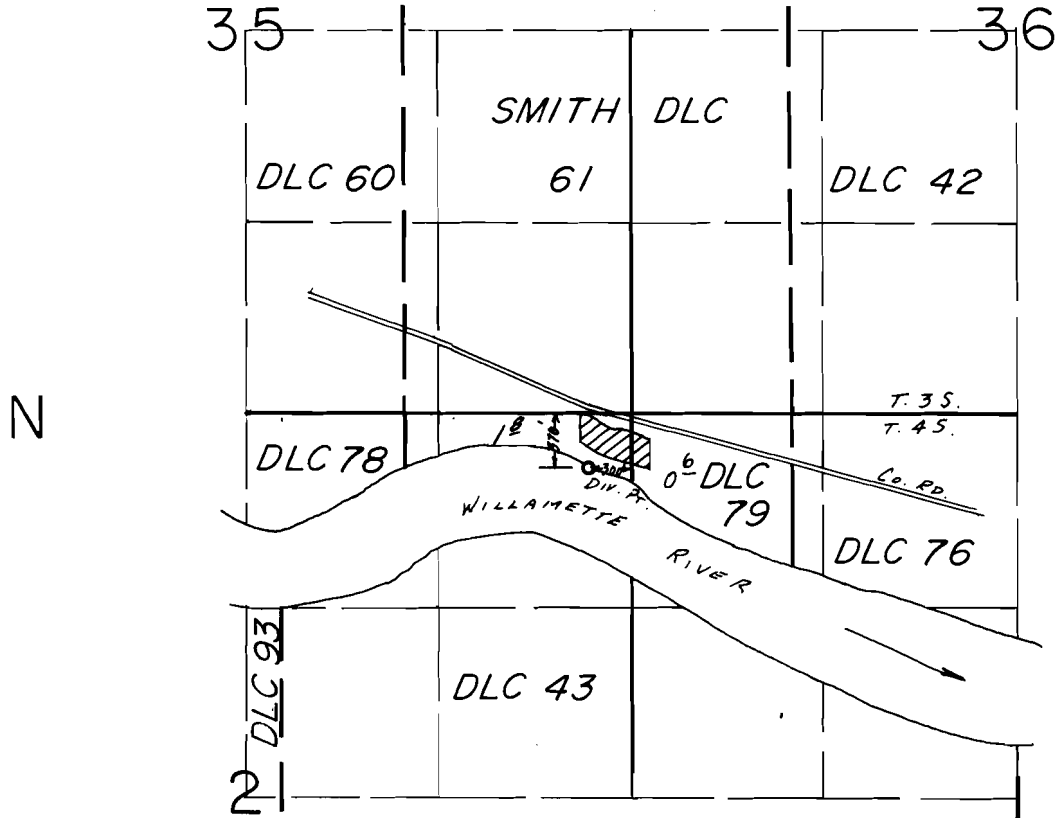

SCALE: 1" = 1320'

FINAL PROOF SURVEY
UNDER

Application No. 56253... Permit No. 41788.....
IN NAME OF

.....GEORGE D. KENYON.....

Surveyed July 20... 19.87, by B.W. BISHOP.....