


T.36S., R.2W., W.M.

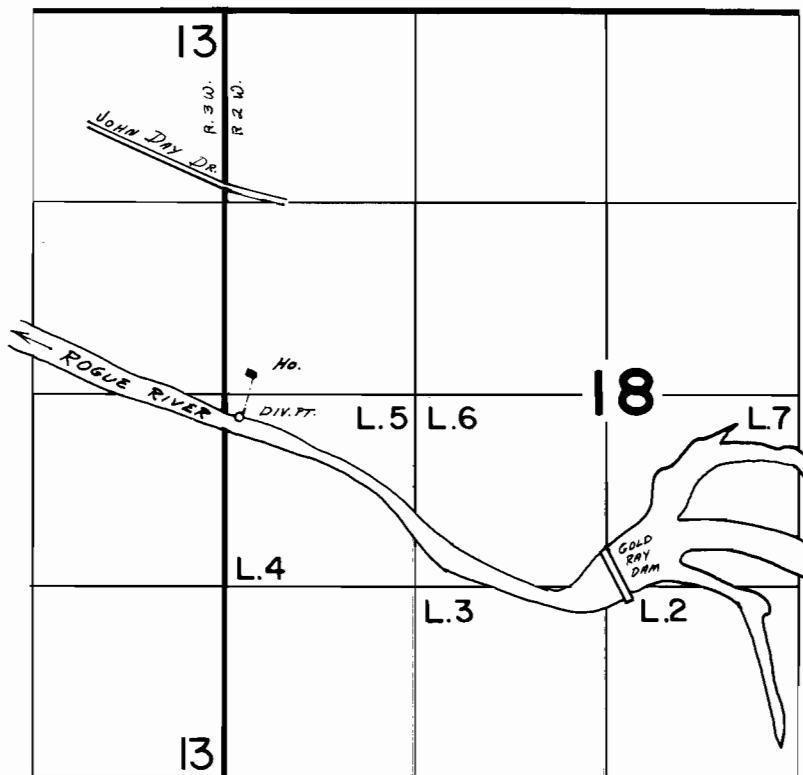

DIV. PT.: 150'S & 100'E FROM THE W 1/4 COR. SECTION 18.

Scale 1"=1320'

FINAL PROOF SURVEY UNDER

Application No. 56546. Permit No. 42134.....
IN NAME OF

KENNETH R. &/or VIRGINIA S. McGRAW

Surveyed JUNE 1 1987, by B.S. JAMES.....