


T.26S., R.7W., W.M.
SEC. 24

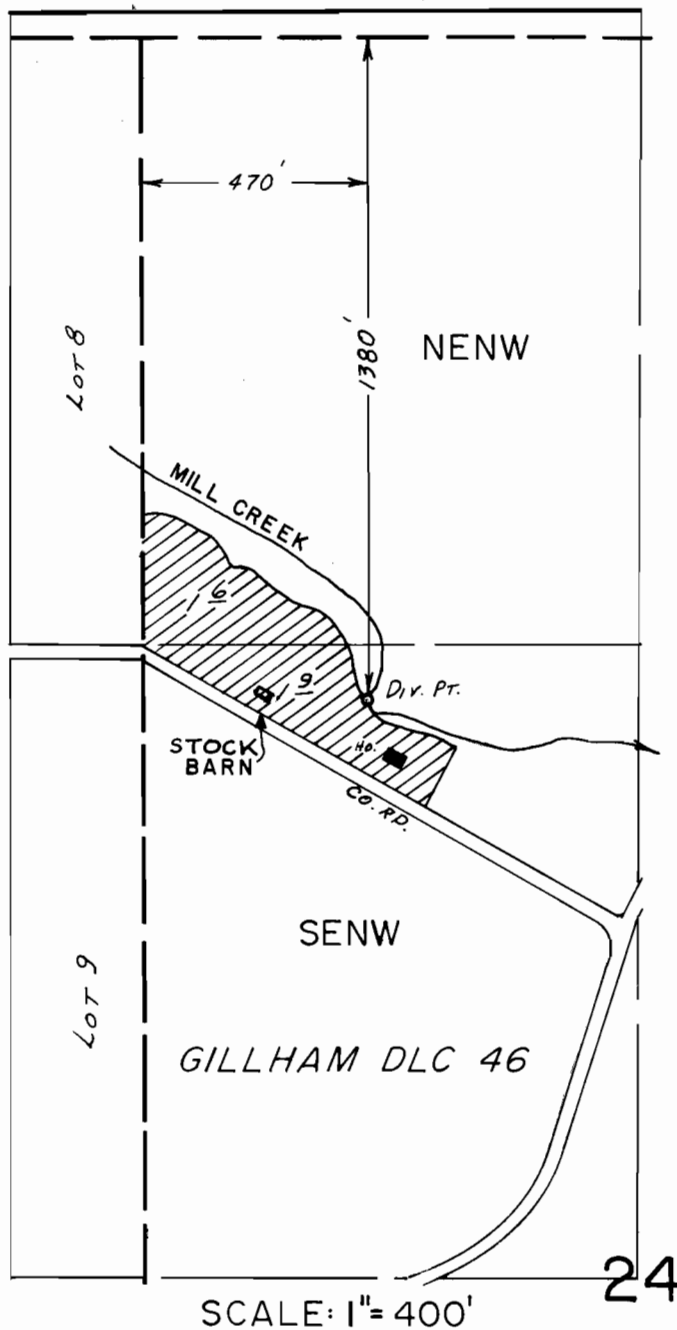

FINAL PROOF SURVEY
UNDER

Application No. 56227 Permit No. 42162.....
IN NAME OF

.....NICHOLAS SCHOON.....

Surveyed MAR. 26 1980, by J.S. DONALDSON