


T.15 S., R.5W., W.M.

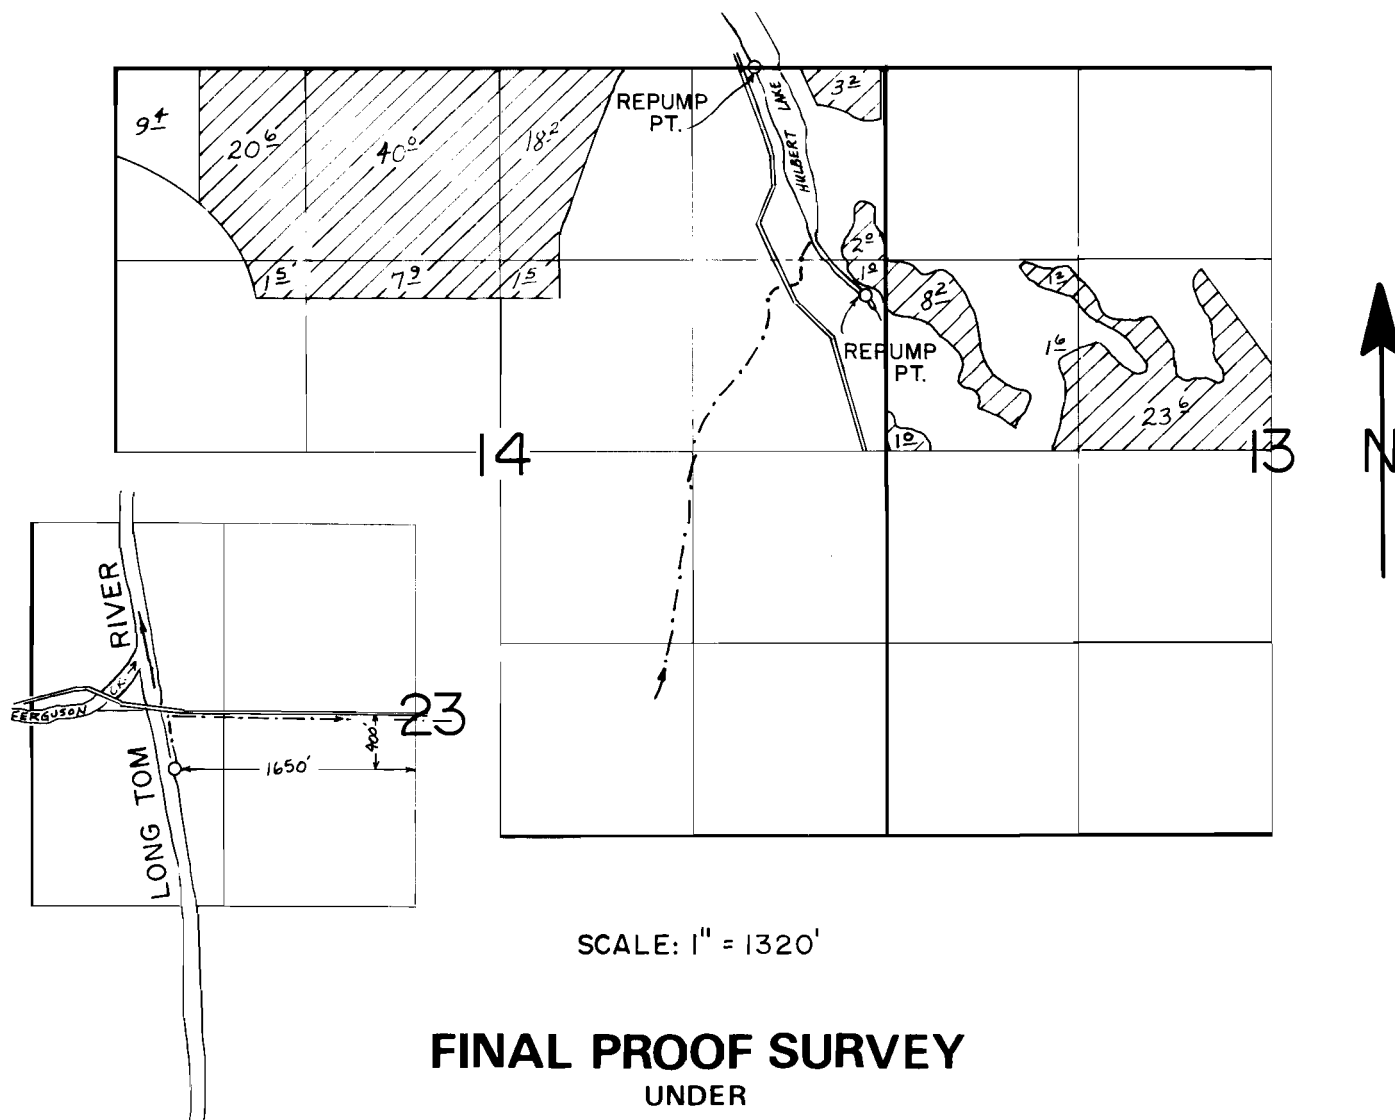

FINAL PROOF SURVEY UNDER

Application No. 55770 Permit No. 4218—
IN NAME OF

GILLIS AND LELA STROME

Surveyed MAY 10 1984, by P.R. PAGTER
Oct. 6 1986 B.W. BISHOP

REVISED 1-16-87 BWD
M.B.

41039 278 182R