




T. 23 S., R. 12 W., W.M.

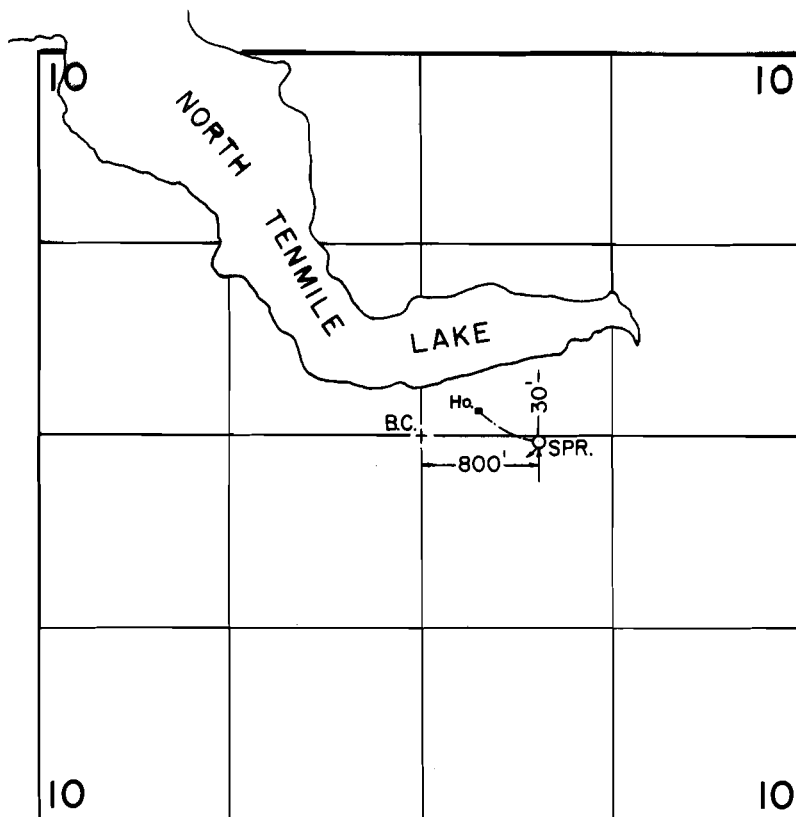

SCALE: 1" = 1320'

FINAL PROOF SURVEY UNDER

Application No. 56729 Permit No. 42486
IN NAME OF

H. M. RUBERG

Surveyed SEPT. 17, 1988, by T. M. WARREN