


T.4S.,R.3W.,W.M.

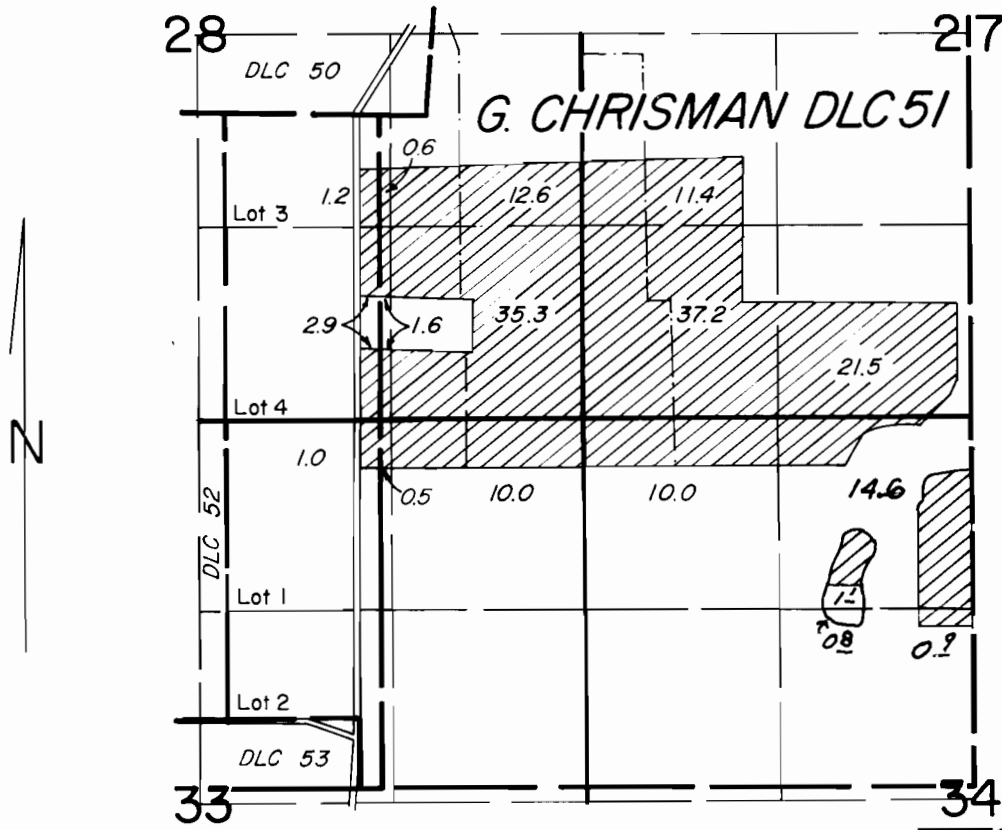

SCALE: 1" = 1320'



FINAL PROOF SURVEY UNDER

Application No. 55385 Permit No. 42526.....

IN NAME OF

WIL WILSON

Surveyed MAY 11, 1979, by Z. SALEH
AUG. 4 1988